


T. 2 S. R. 4 & 5 W. W. M.

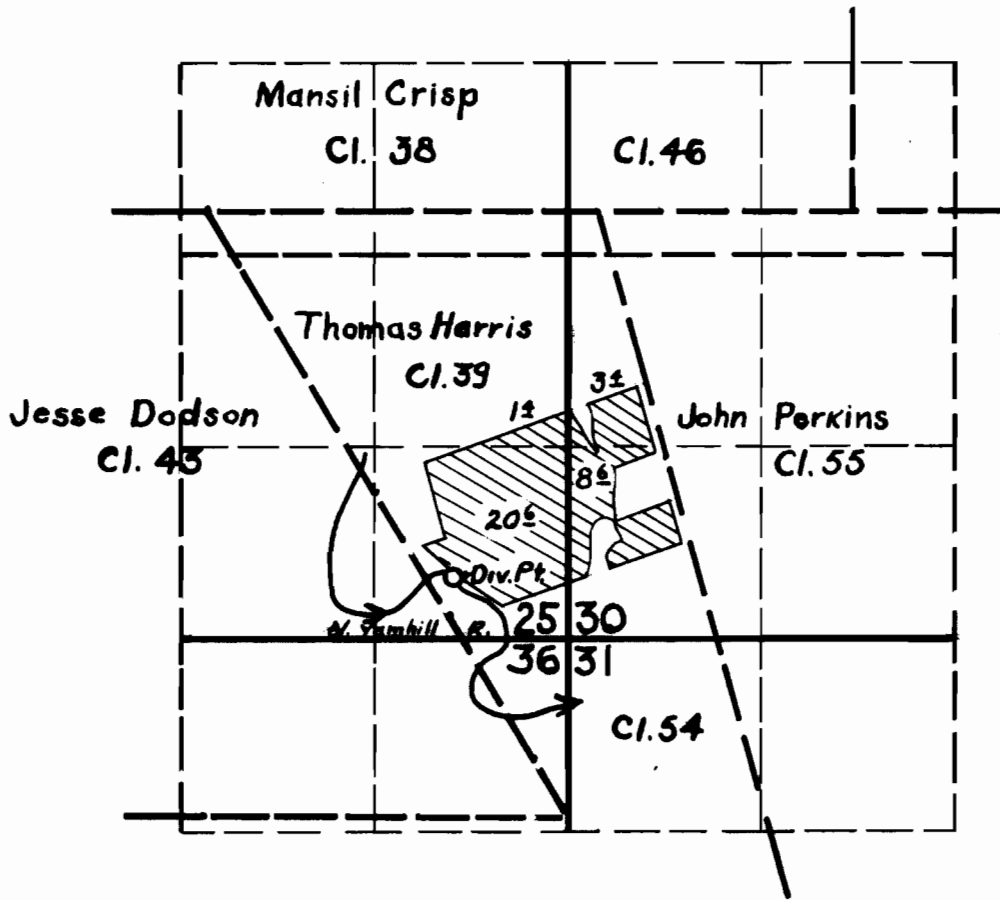

FINAL PROOF SURVEY

UNDER

Application No. 20554 Permit No. 16046
IN NAME OF

DICK & MARTHA DE WITH

Surveyed 2 May 1955, by H. Coffman