


T. 29S, R. 14 & 15 W.W.M.

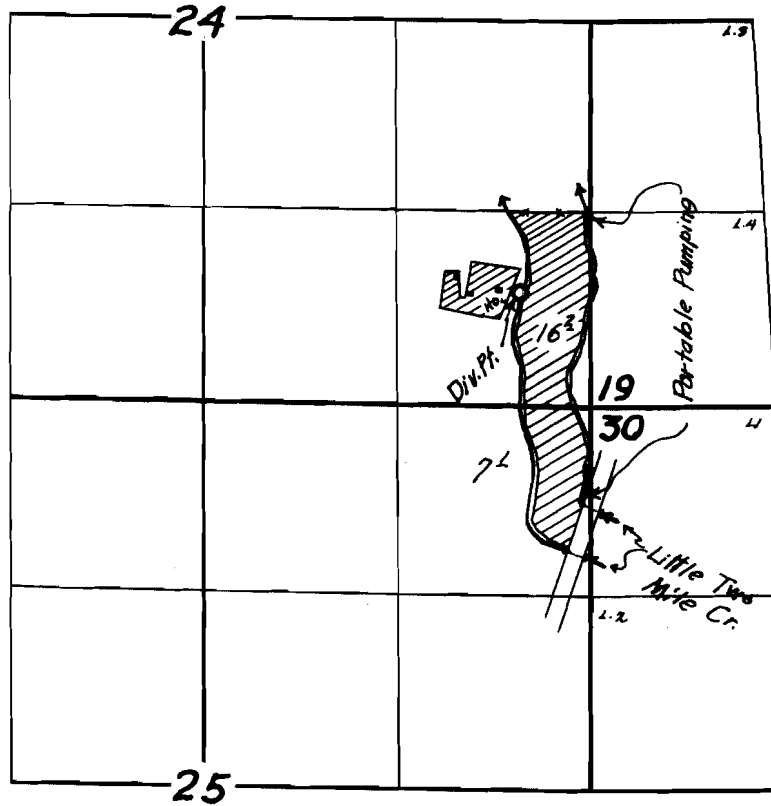

FINAL PROOF SURVEY

UNDER

Application No. 20570... Permit No. 16074...
IN NAME OF

NORMAN McCLEOD HELME

Surveyed 11 March 1955, by H. L. Coffman...