
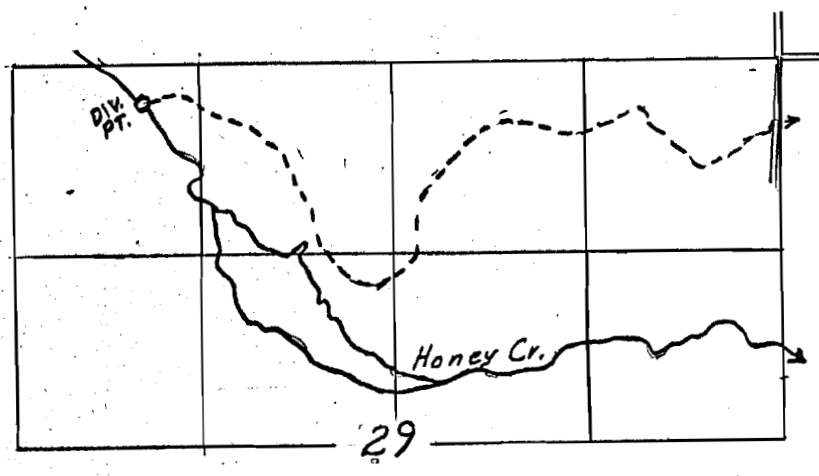


T. 36 S. R. 24 E. WM

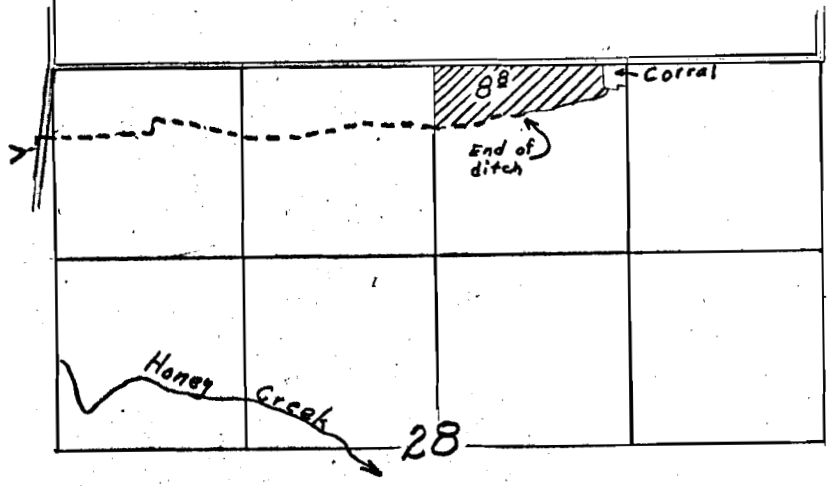

FINAL PROOF SURVEY

UNDER

Application No. 20643 Permit No. 16147

IN NAME OF

J.P. Egan

Surveyed 6-15-1955, by T. Jones

36-24 ✓