


T. 3S. R. 10W. W.M.

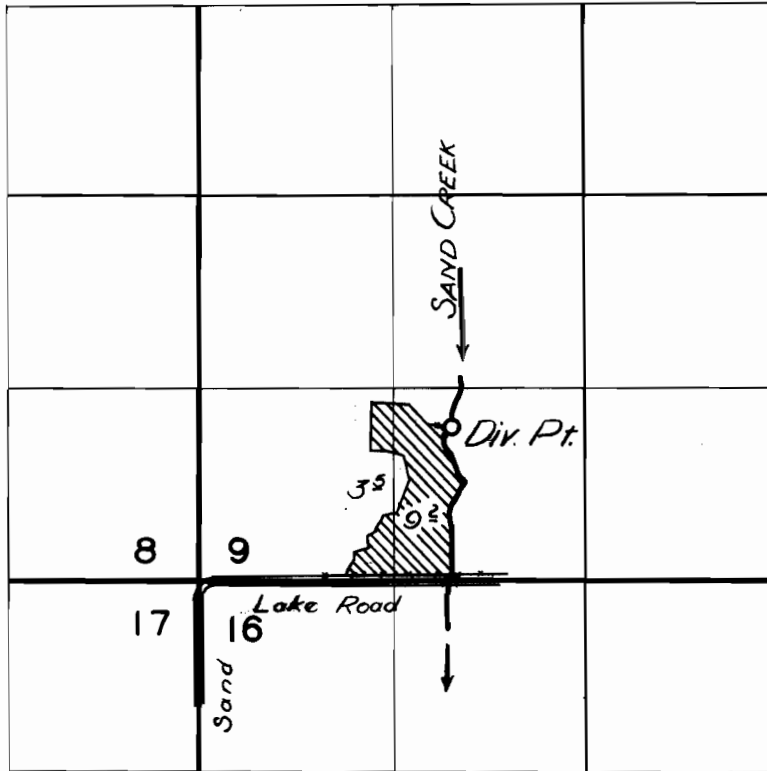

FINAL PROOF SURVEY

UNDER

Application No. 21034 Permit No. 16453

IN NAME OF

JOHN GREEN

Surveyed 18, Aug 1955, by *E. M. Whitley*