


T. 3S.R. 10W.W.M.

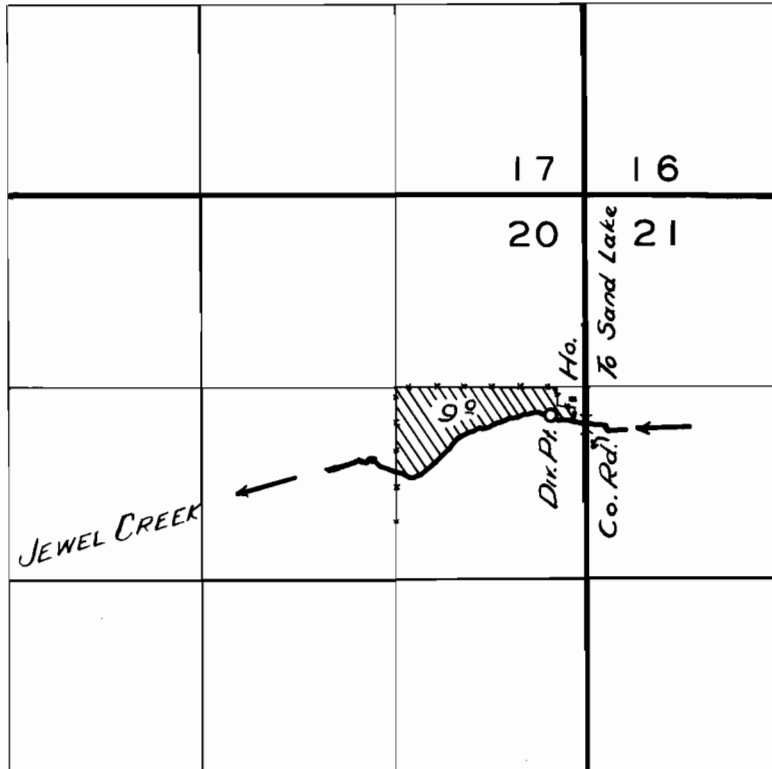

FINAL PROOF SURVEY

UNDER

Application No. 21022 Permit No. 16481

IN NAME OF

JESSE SHORTLIDGE

Surveyed 10 Aug 1955, by *[Signature]*