


T.24 S.R.13 W.W.M.

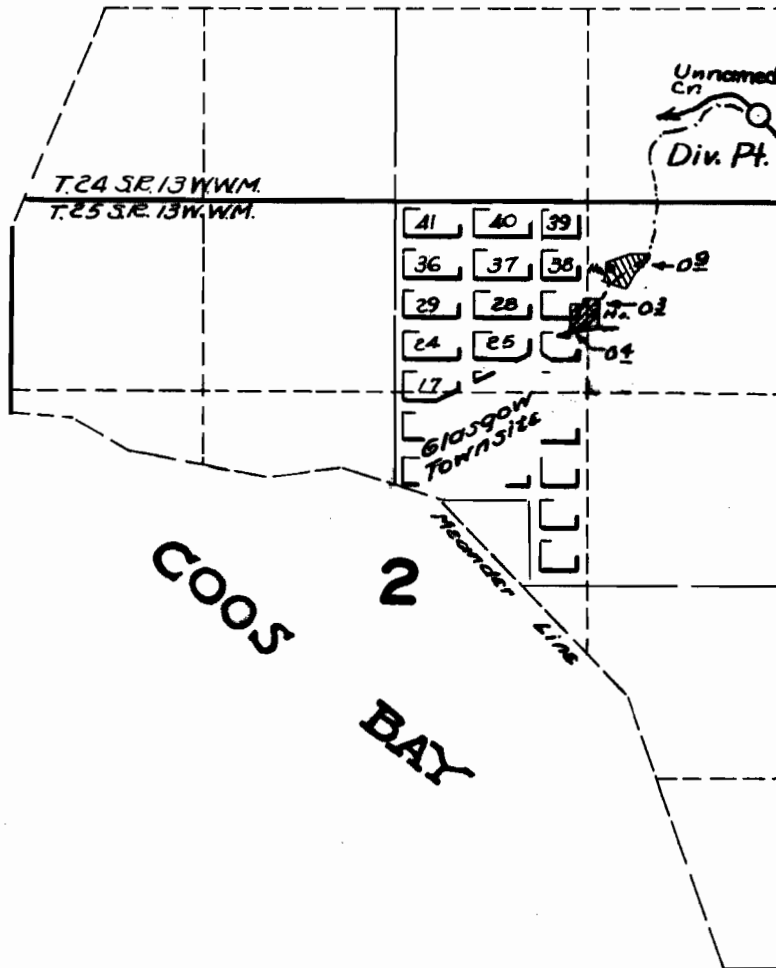

FINAL PROOF SURVEY

UNDER

Application No. 21159.... Permit No. 16580.

IN NAME OF

GUNDER GUNDERSON & GEORGE GRANFORS

Surveyed AUG. 27. 1949., by H.L. COFFMAN