


T.29 S.R.5&6W.WM

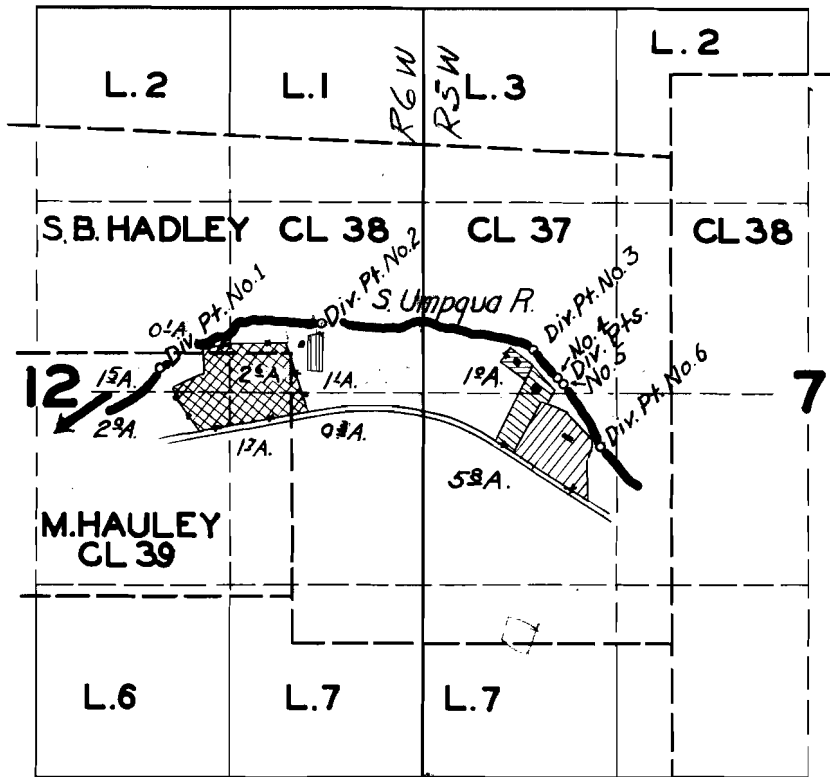

- J.D. McCann
- Clay Ulam
- C. Forrest
- E.B. Bishoff
- W.E. DeWitt

FINAL PROOF SURVEY UNDER

Application No. 21516 Permit No. 16873

IN NAME OF

ARNOLD M. HELGESON

Surveyed Sept. 3 1953, by T. Jones