


TINRIOWWM

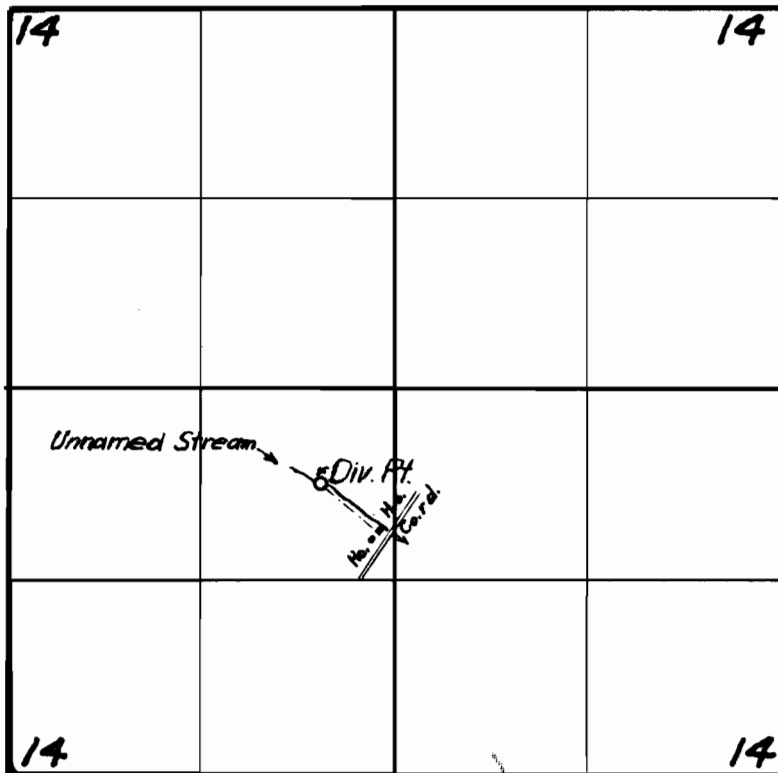

**FINAL PROOF SURVEY**

UNDER

Application No. 21542... Permit No. 16892...

IN NAME OF

***Edward E. & Mary G. Sullivan***

Surveyed *July 20 1955*, by *M. Bish*.....