


T29#28SR14WWM

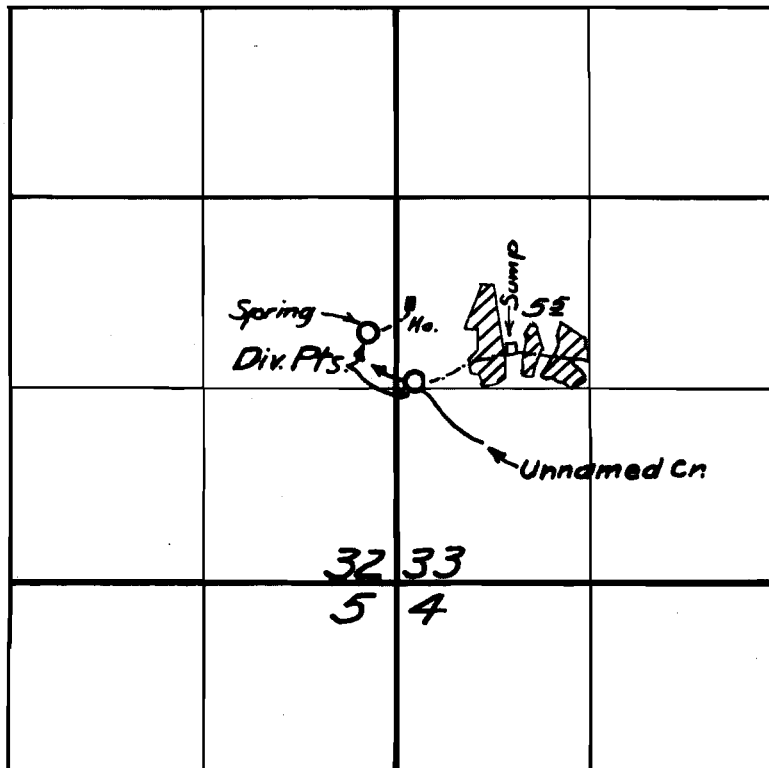

FINAL PROOF SURVEY

UNDER

Application No. 21552 Permit No. 16898

IN NAME OF

Elmer J. Allinger

Surveyed Aug 16 1955 by M. Bish