


T4S, R5W, WM.

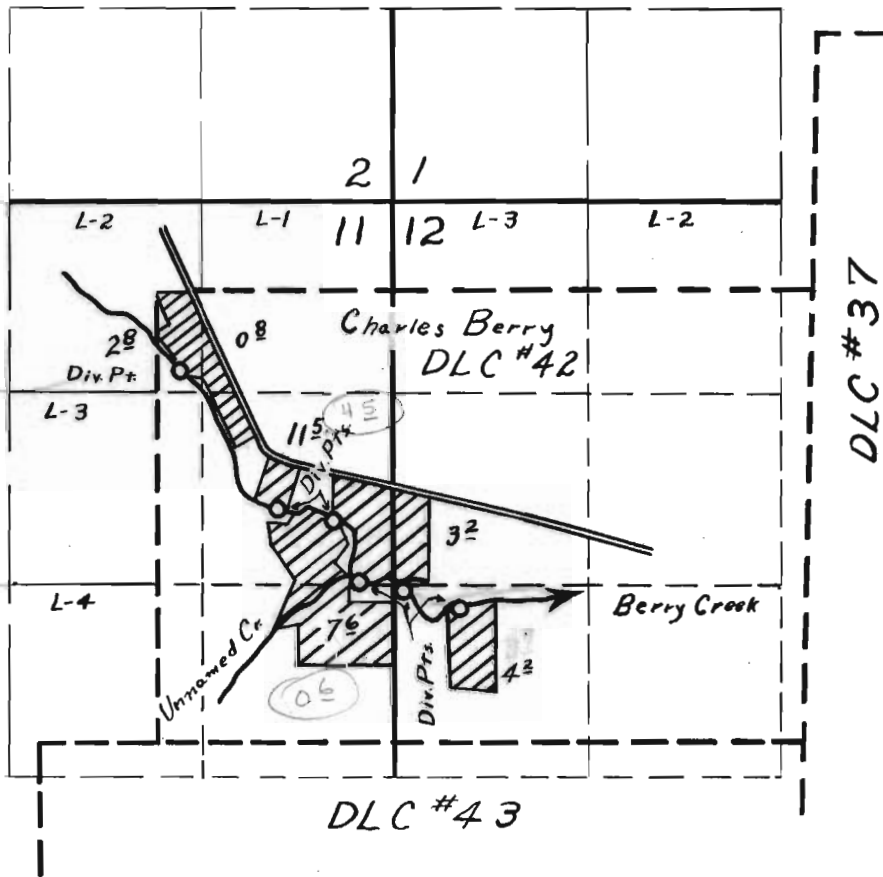

FINAL PROOF SURVEY
UNDER


Application No. 21506 Permit No. 16930
IN NAME OF

Fred Smalley

Surveyed 9-29 1956, by R.H. Whitby

T. 4 S. R. 5 W. W.M.

VOID

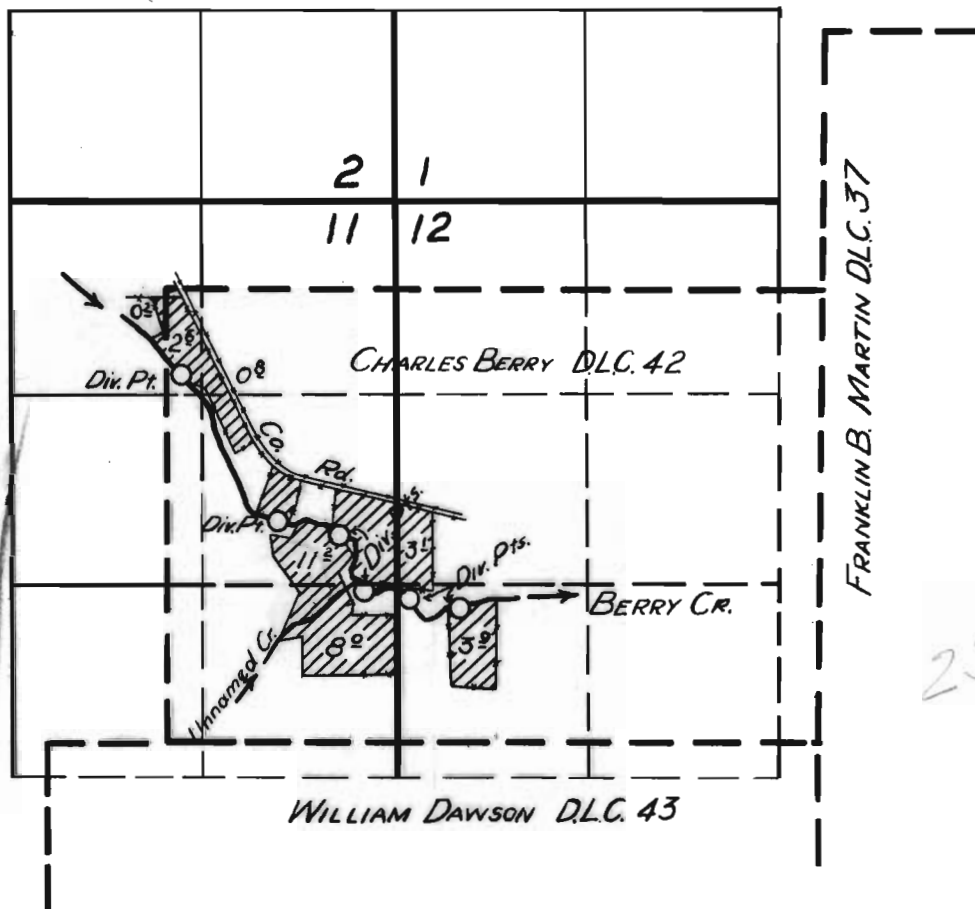

29/9

FINAL PROOF SURVEY

UNDER

Application No. 21506 Permit No. 16930

IN NAME OF

FRED SMALLEY

Surveyed 29 Sep. 1955, by

1955-E