


T. 2 S. R. 3 W. W.M.

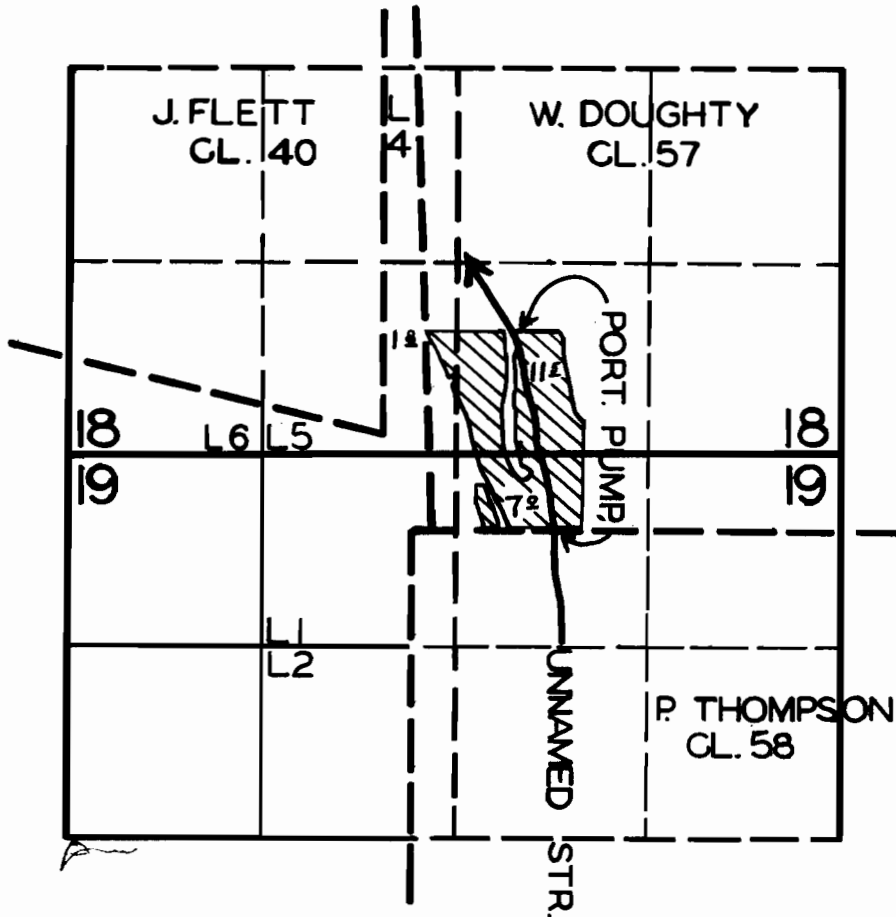

FINAL PROOF SURVEY
UNDER

APPLICATION NO. ~~21707~~ PERMIT NO. ~~17096~~

IN NAME OF
Thomas E. Twigg

SURVEYED ~~28 APR~~ 1955, BY H. COFFMAN