


T. 9 S. R. 2 E. W. M.

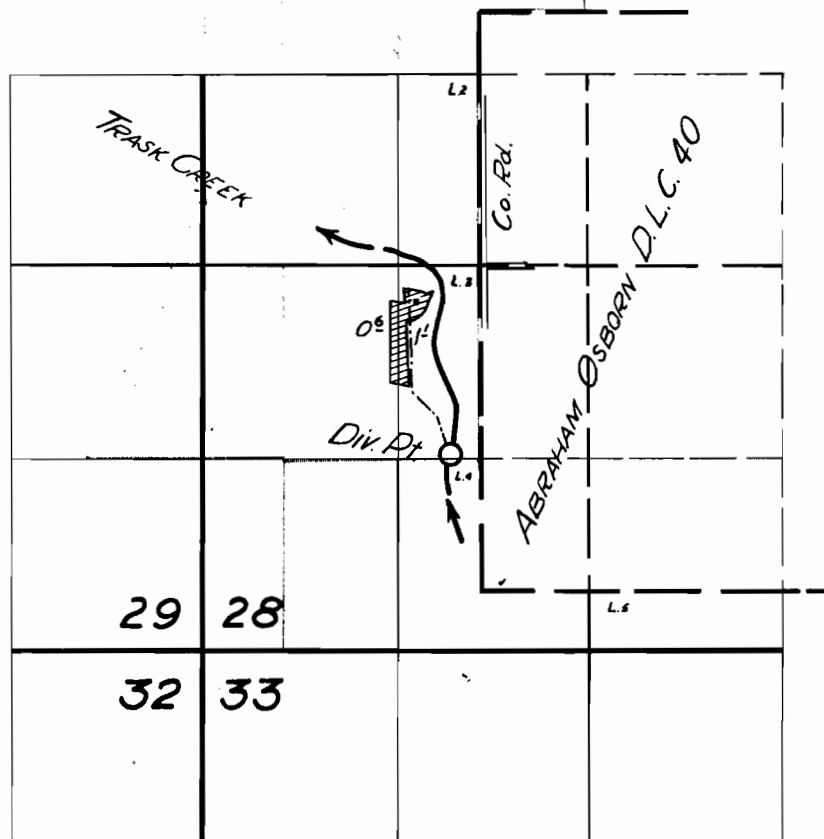

FINAL PROOF SURVEY
UNDER

Application No. 22016 Permit No. 17302
IN NAME OF

HARLEY SCOTT

Surveyed 31 Mar 1955, by T. JONES

1955-Y