


T.29S, R.14W.W.M.

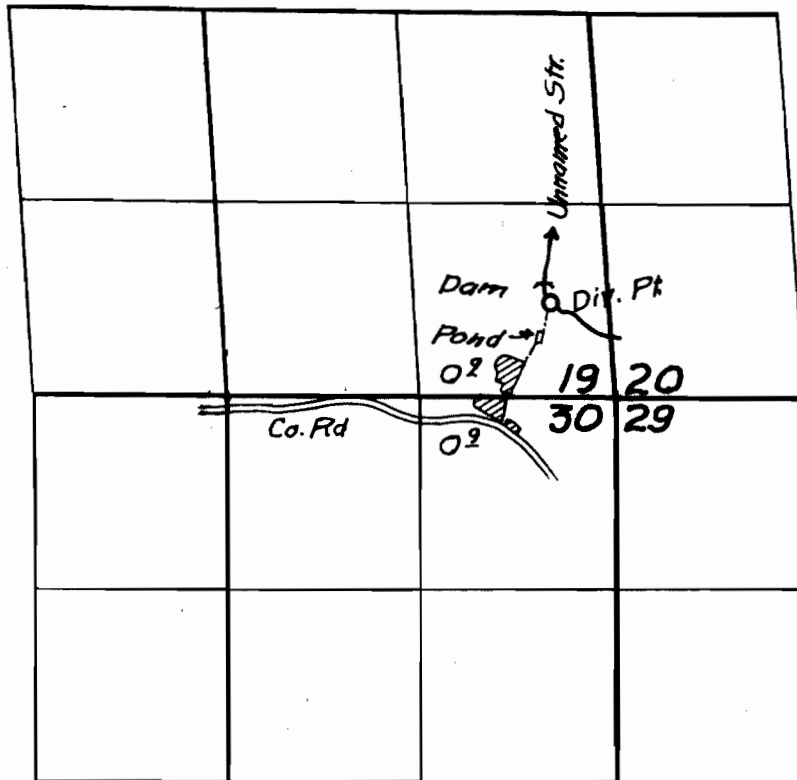

FINAL PROOF SURVEY
UNDER

Application No. 22134 Permit No. 17432
IN NAME OF

FRANK H. GOULD

Surveyed 15 March 1935, by H. L. Coffman.