


T.29S, R.14 & 15W.W.M.

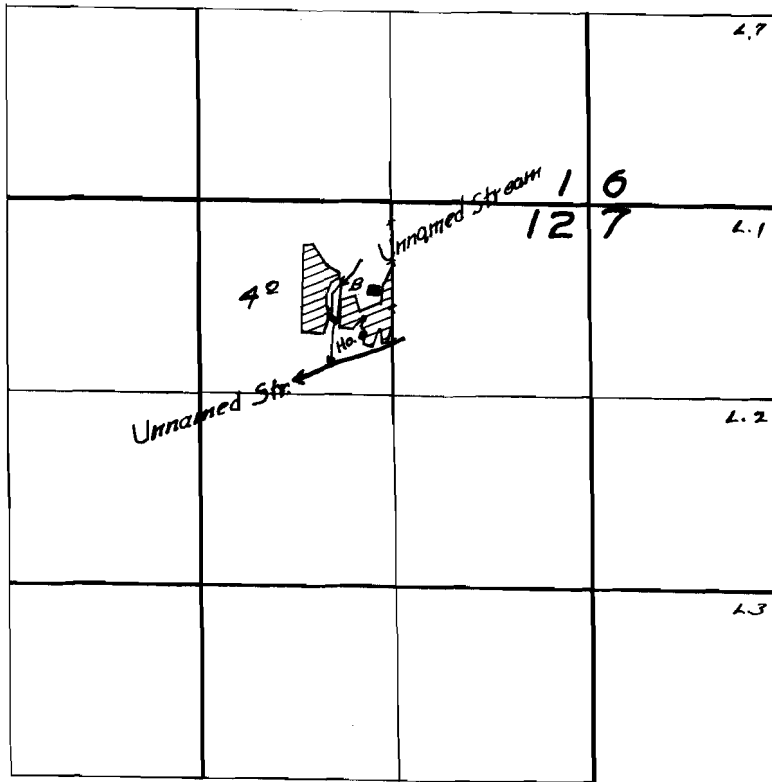

FINAL PROOF SURVEY
UNDER

Application No. 22329 Permit No. 17606
IN NAME OF

D.H. Cogdill

Surveyed 16 March 1935, by H.L. Coffman