


T.4S. R.4W.WM

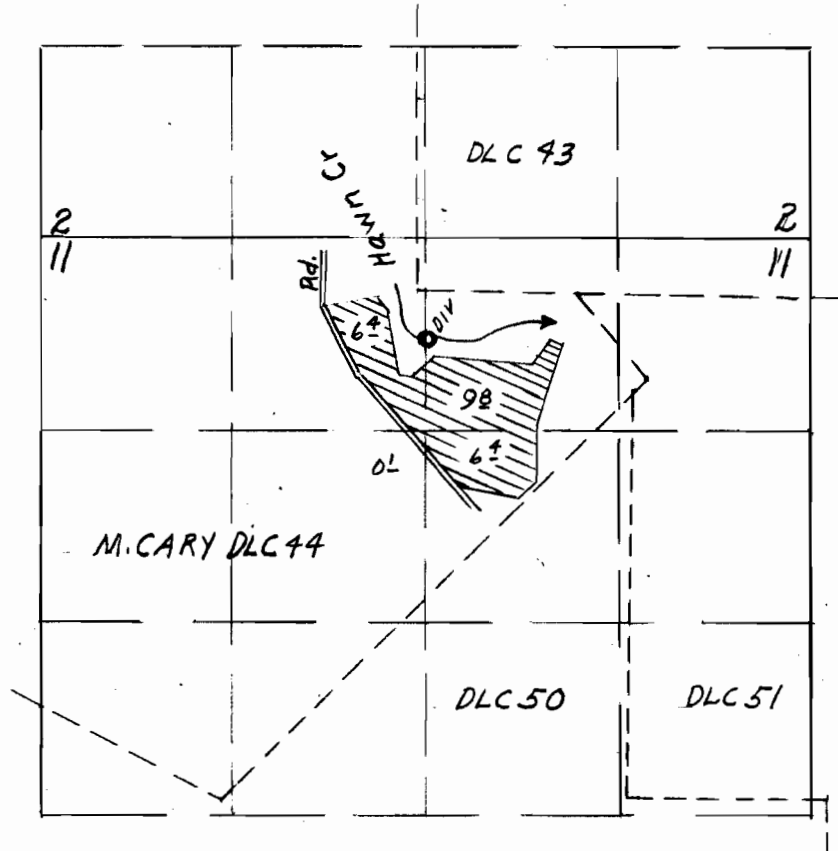

FINAL PROOF SURVEY
Under

Application No 22588 Permit No 17777
In name of

H.A. Bell

Surveyed Sep 20 1956 by R.H. Whitby