


T. 9 S. R. 3 E. W. M.

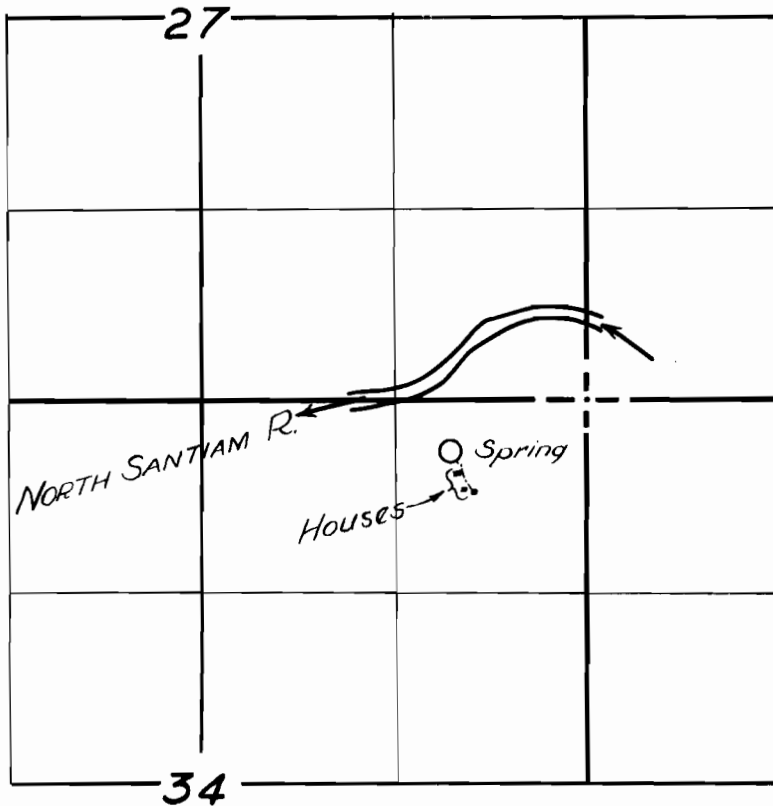

FINAL PROOF SURVEY

UNDER

Application No. 22667 Permit No. 17805

IN NAME OF

L. O. KUHLMAN

Surveyed 4 Apr 1955, by T. JONES