


T. 4 S. R. 4 W. W. M.

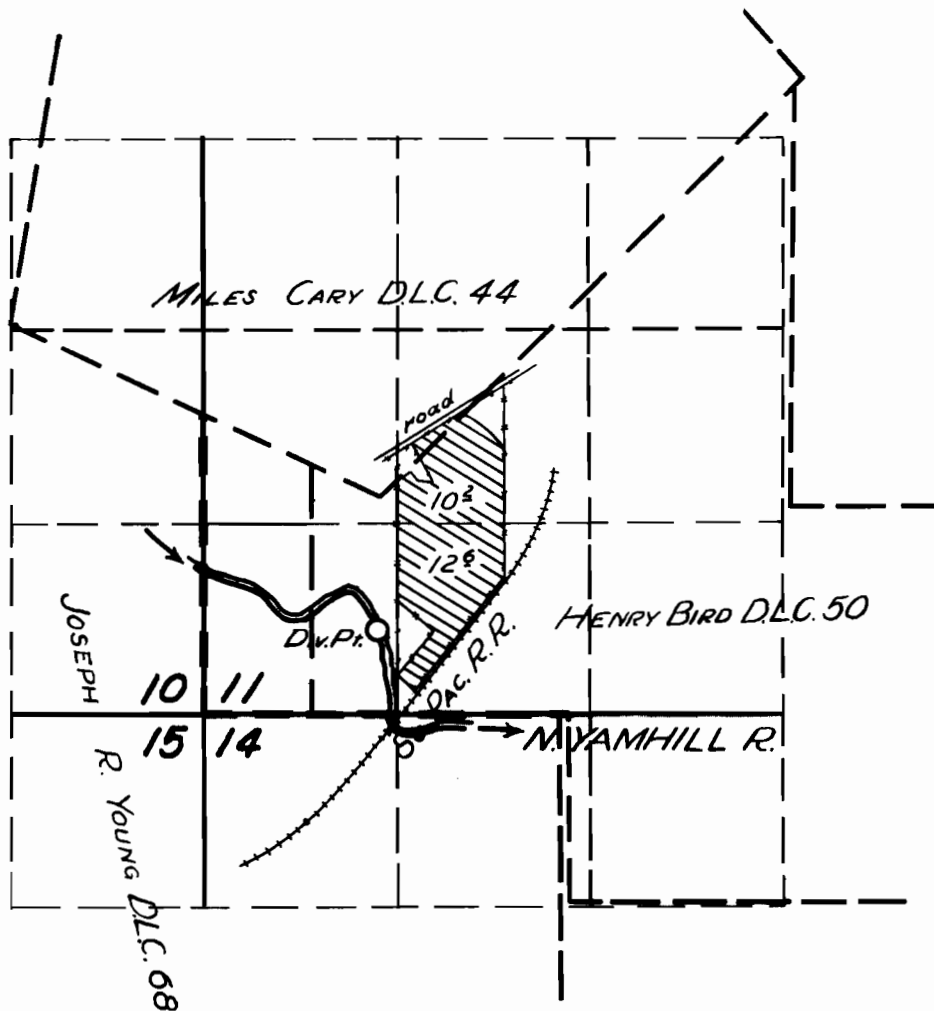

FINAL PROOF SURVEY

UNDER

Application No. 23055 Permit No. 18/58

IN NAME OF

PAUL YOUNGMAN

Surveyed 20 Sep. 1955, by *W. D. Whiteley*