


T.30S.R.12W.W.M.

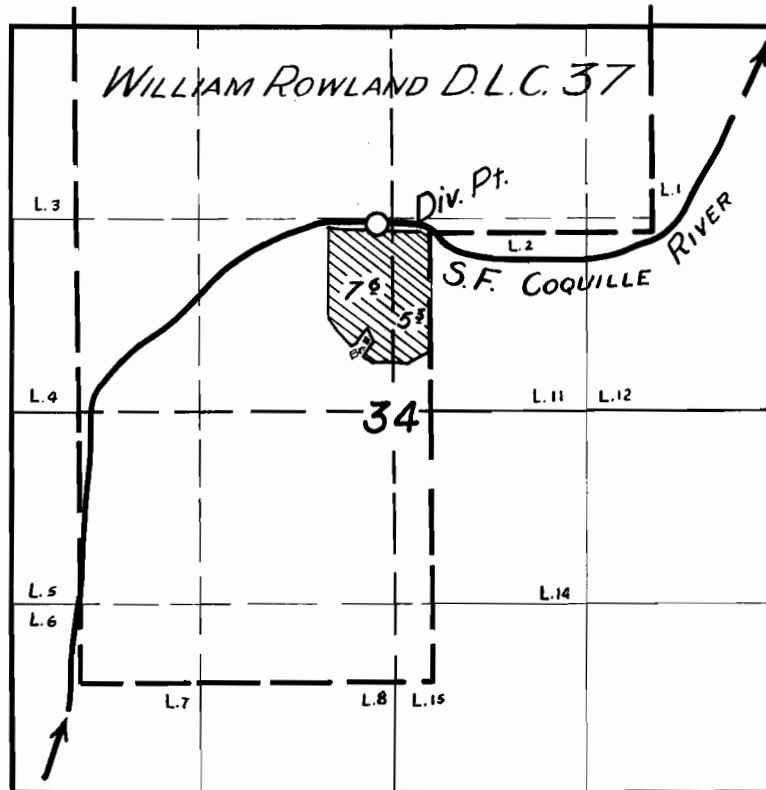

FINAL PROOF SURVEY
UNDER

Application No. 23148 Permit No. 18238
IN NAME OF

CLARENCE R. GRANT

Surveyed 21 Mar. 1955, by T. JONES

1955-Y