


T. 1 & 2 S. R. 45 E. W. M.

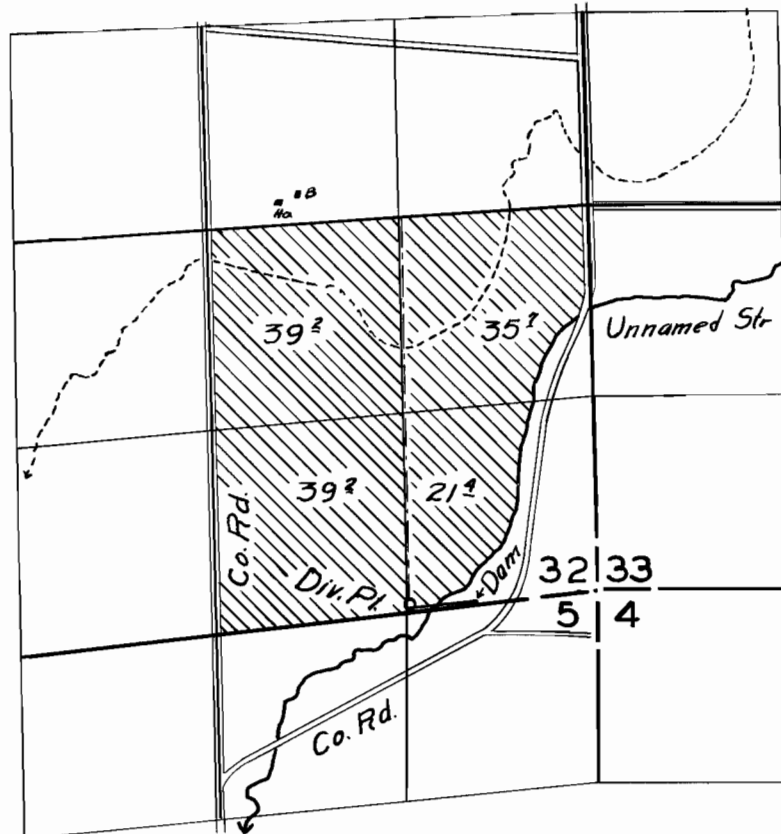

FINAL PROOF SURVEY

UNDER

Application No. 23149. Permit No. 18239

IN NAME OF

W. C. GETTINGS & EUGENE V. ZACHARIAS

Surveyed 16 AUG. 1955, by *Robert H. Beard*