


T I S R I O W. W. M.

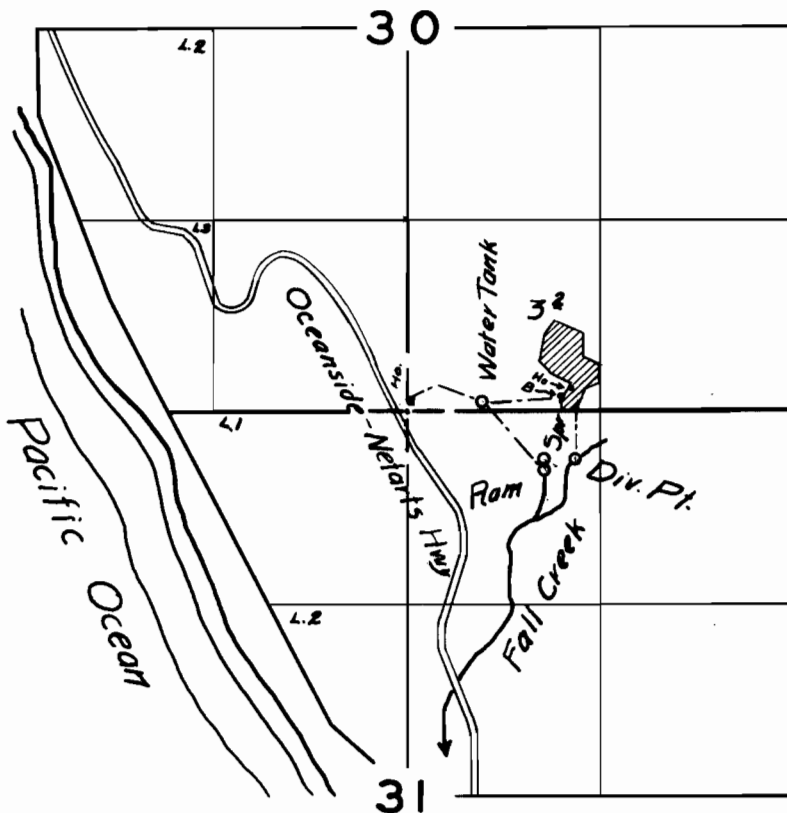

FINAL PROOF SURVEY

UNDER

Application No. 23187 Permit No. 18340

IN NAME OF

WALTER UNDERWOOD, SR.

Surveyed 18 July 1955, by Robert H. Reed