


T1&25R9WWM

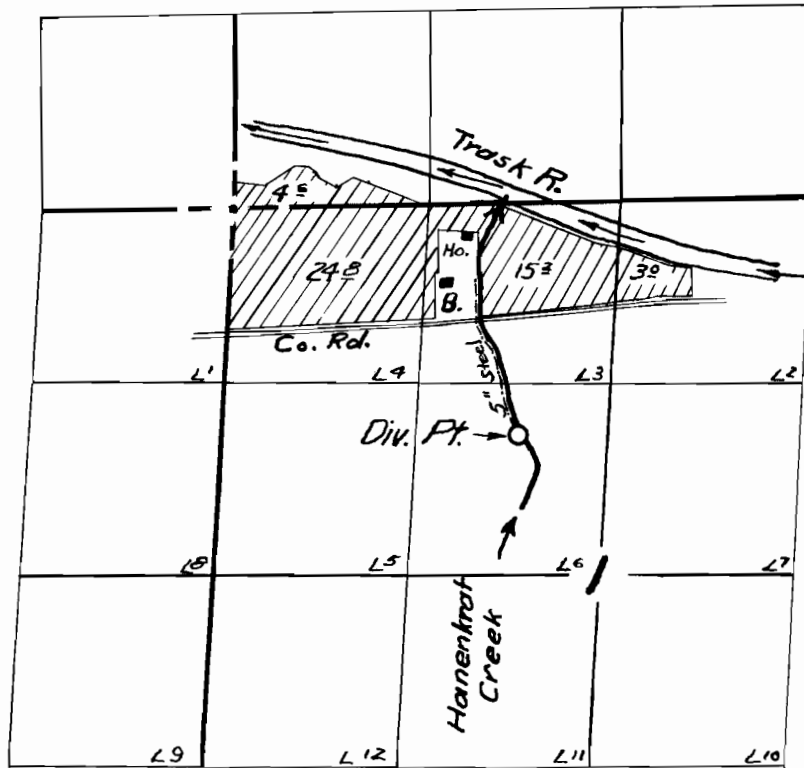

FINAL PROOF SURVEY

UNDER

Application No. *23485* Permit No. *18576*

IN NAME OF

Edward J. Hankenkrat

Surveyed *July 28* 1955, by *M. Seal*