


T. 9 S. R. 3 E. W. M.

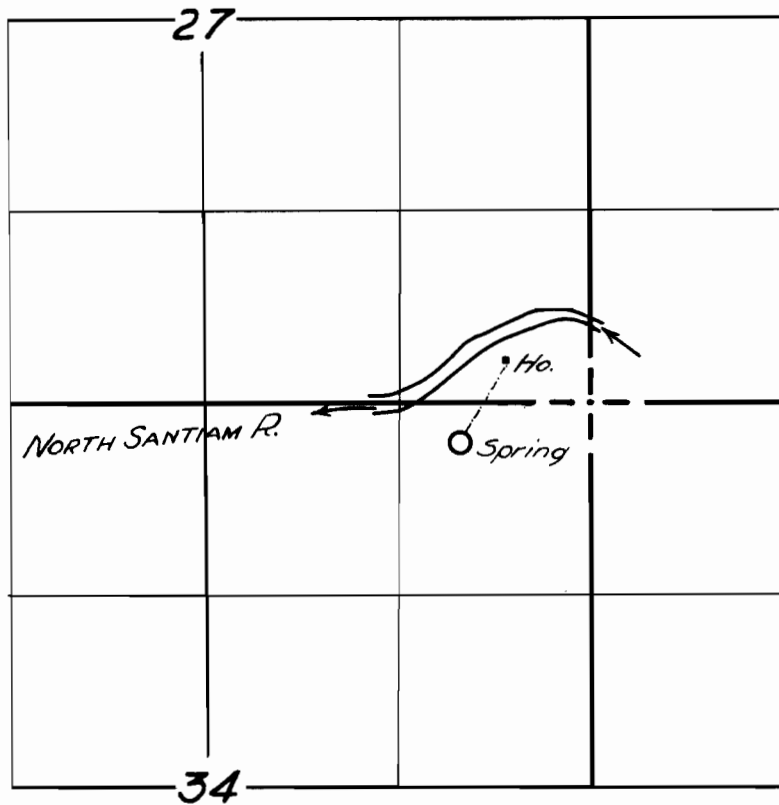

FINAL PROOF SURVEY

UNDER

Application No. 23662 Permit No. 18655

IN NAME OF

EMIL JOHNSON

Surveyed 4 Apr. 1955, by T. JONES

1955-Y