


T. 9 S. R. 3 E. W. M.

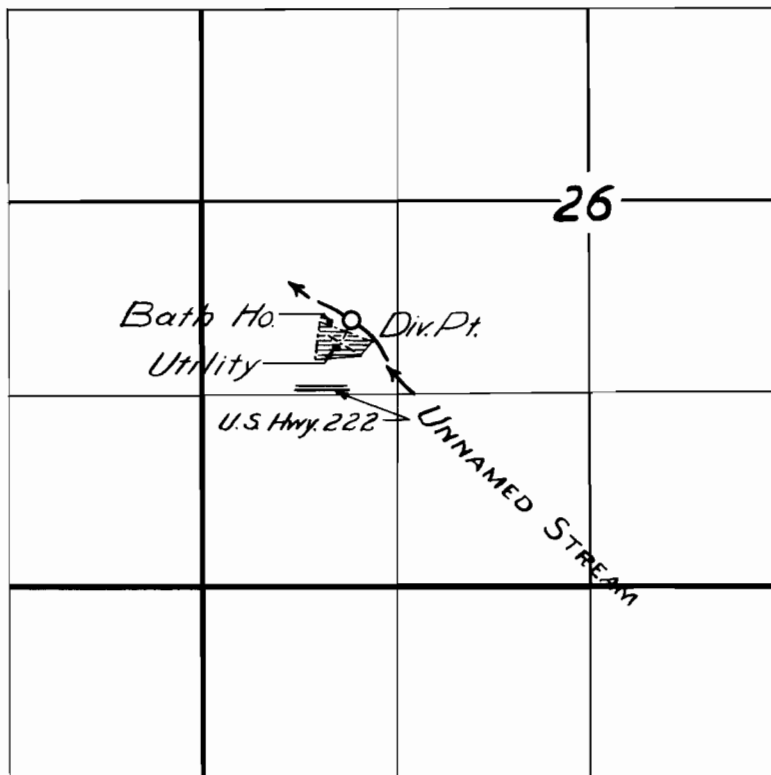

**FINAL PROOF SURVEY**

UNDER

Application No. 23638 Permit No. 18692

IN NAME OF

***ESTATE of GEORGE W. CLISE***

Surveyed 6 Apr 1955, by T. JONES

1955-Y