


T.40 S. R.20 E. W.M.

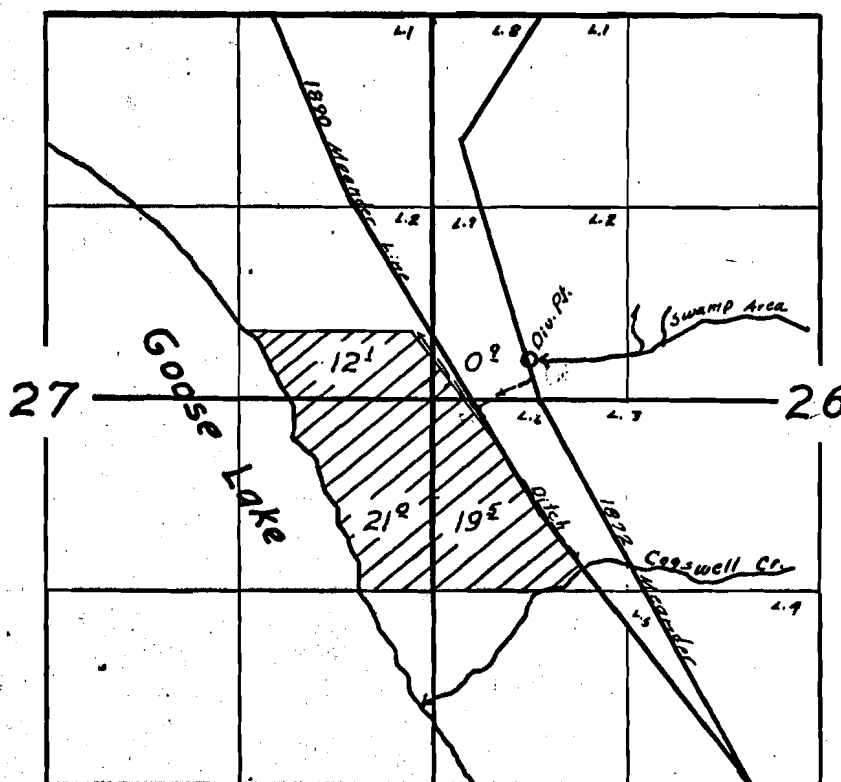

FINAL PROOF SURVEY

UNDER

Application No. 23729.. Permit No. 18738...

IN NAME OF

IN NAME OF
ALFRED & ELLEN ST. CLAIR

J.E. & VIVIAN ST. CLAIR

Surveyed 5 October 1955, by Robert H. Burt

40-20 ✓

CHZ-38K-178