


T. 13 S. R. 32 & 33 E. W. M.

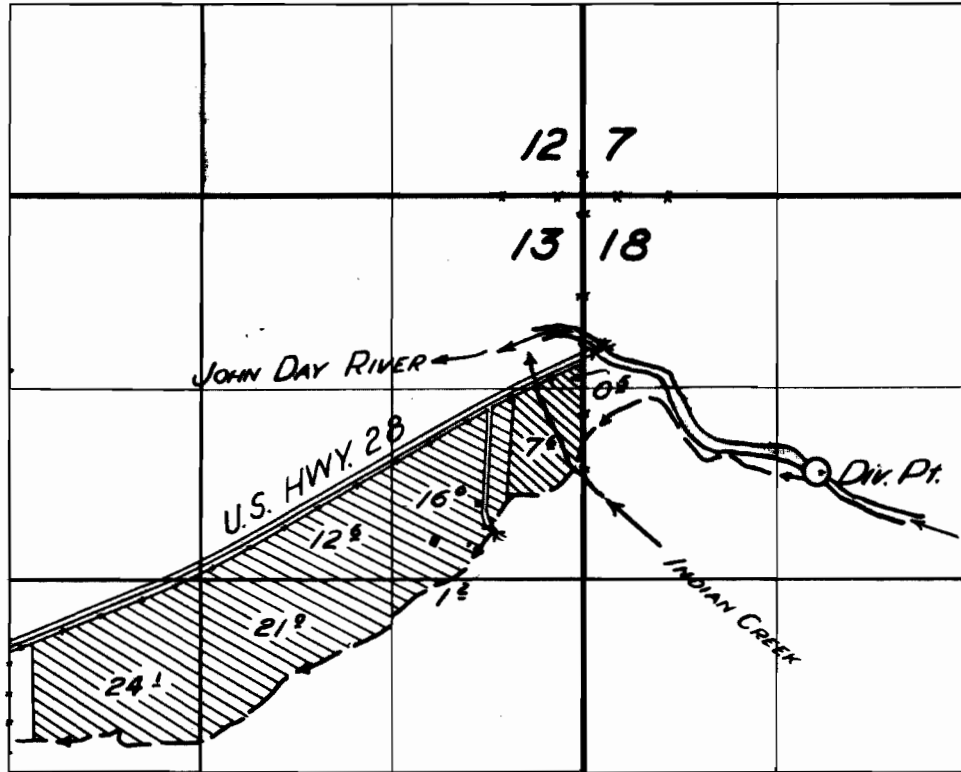

**FINAL PROOF SURVEY**

UNDER

Application No. 23738 Permit No. 18742

IN NAME OF

**HERBERT RICCO**

Surveyed 26 Oct. 1955, by [Signature]