


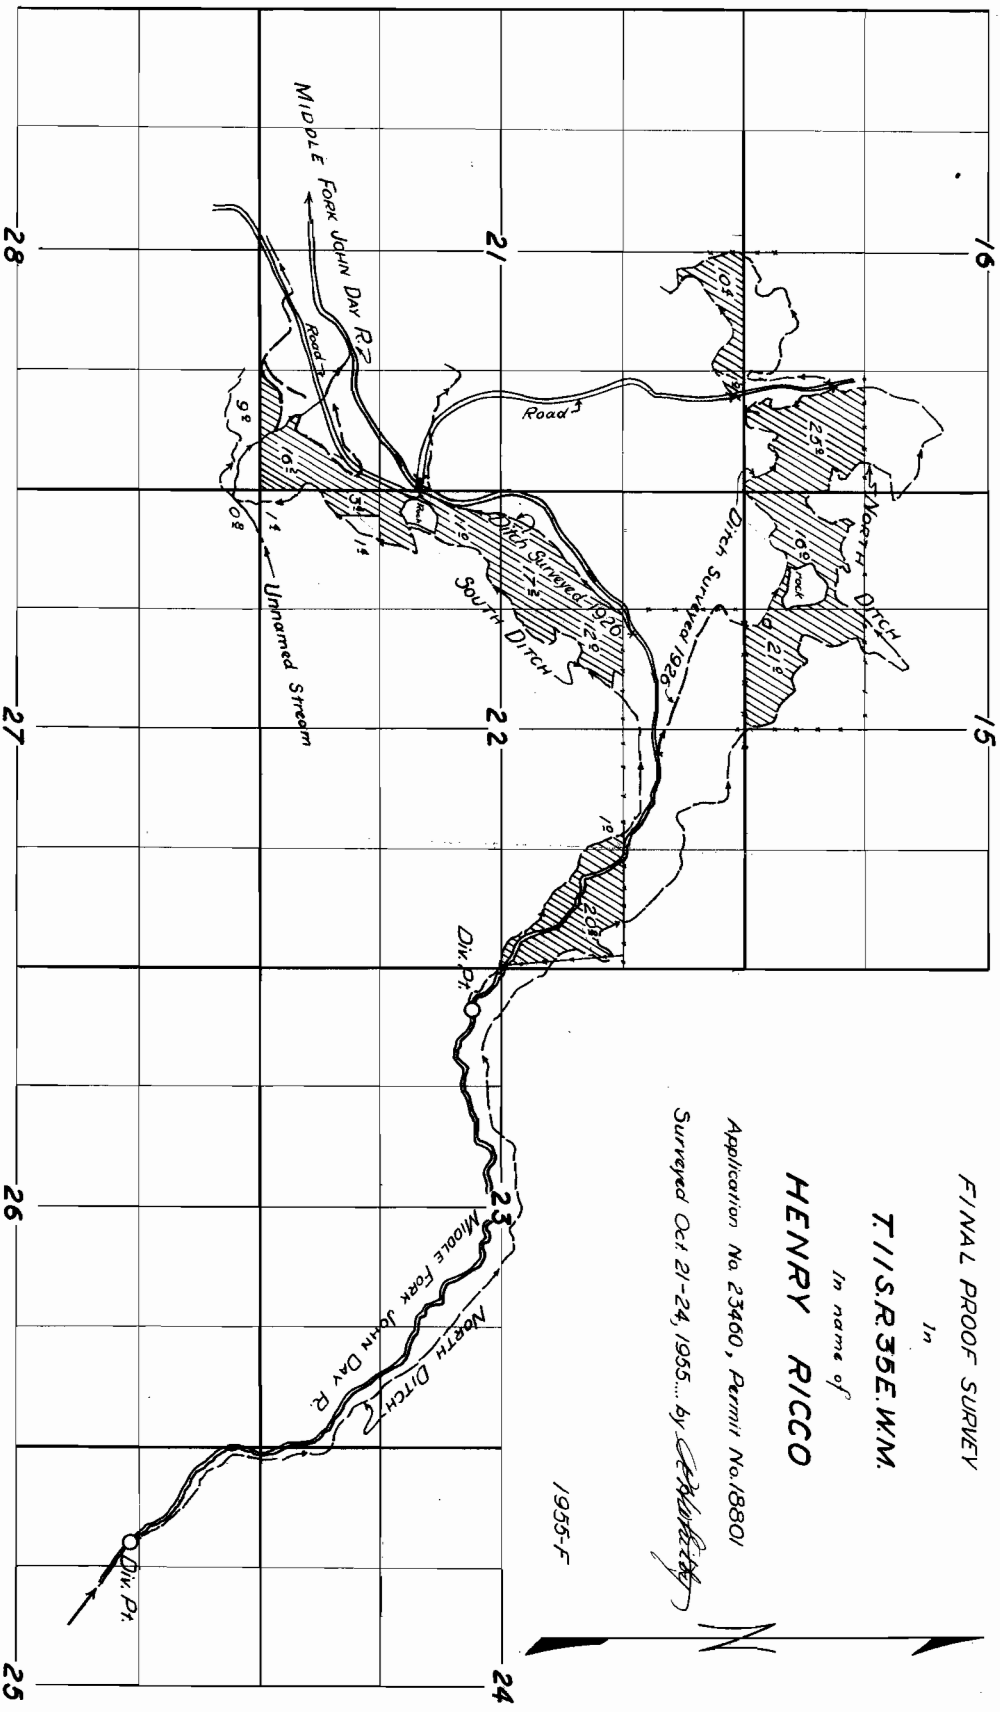

FINAL PROOF SURVEY

In

T.I.S.R. 35E.W.M.

In name of

HENRY RICCO

Application No. 23460, Permit No. 18801


