


T. 13S. R. 18E. W.M.

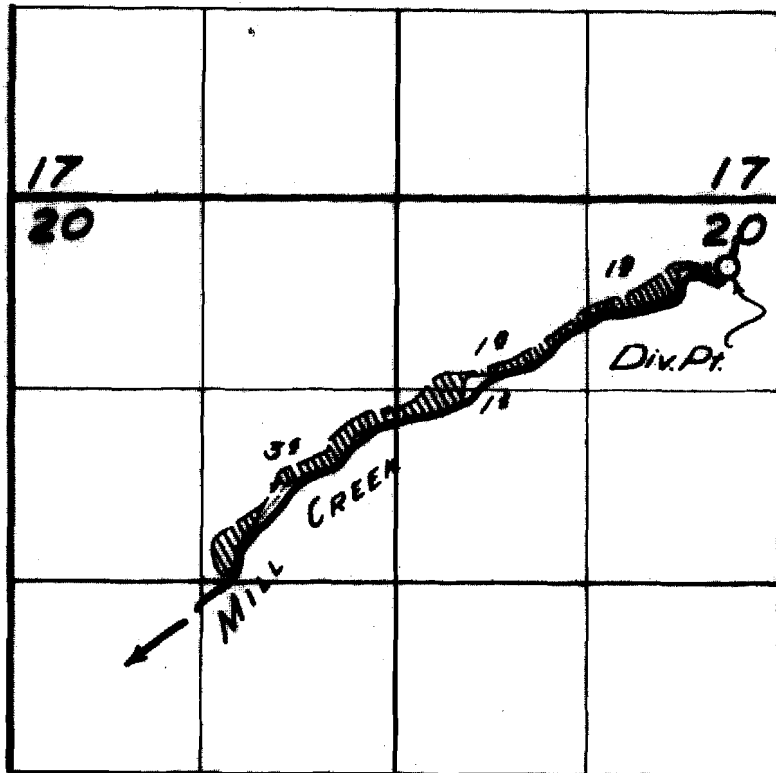

**FINAL PROOF SURVEY**  
UNDER

Application No. 24025 Permit No. 18942  
IN NAME OF

H. R. LAKIN

Surveyed 12 May 1955, by T. JONES

1955-Z