


T30S, R.42E.W.M.

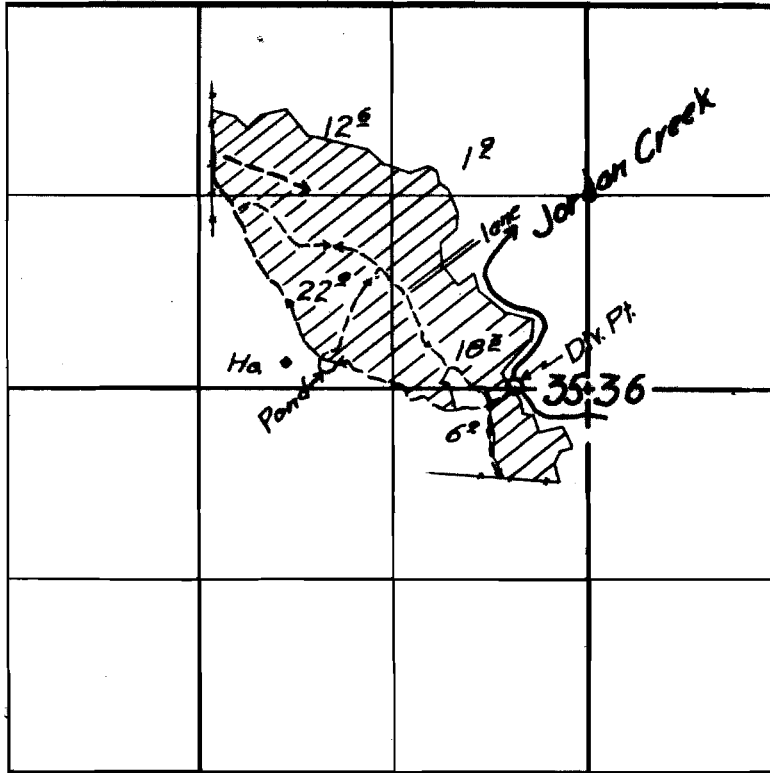

FINAL PROOF SURVEY

UNDER

Application No. 24129... Permit No. 10993...

IN NAME OF

DONALD G. DANNER

Surveyed 26 March 1955, by H.L. Coffman

1955 A.