


T29S R12W WM

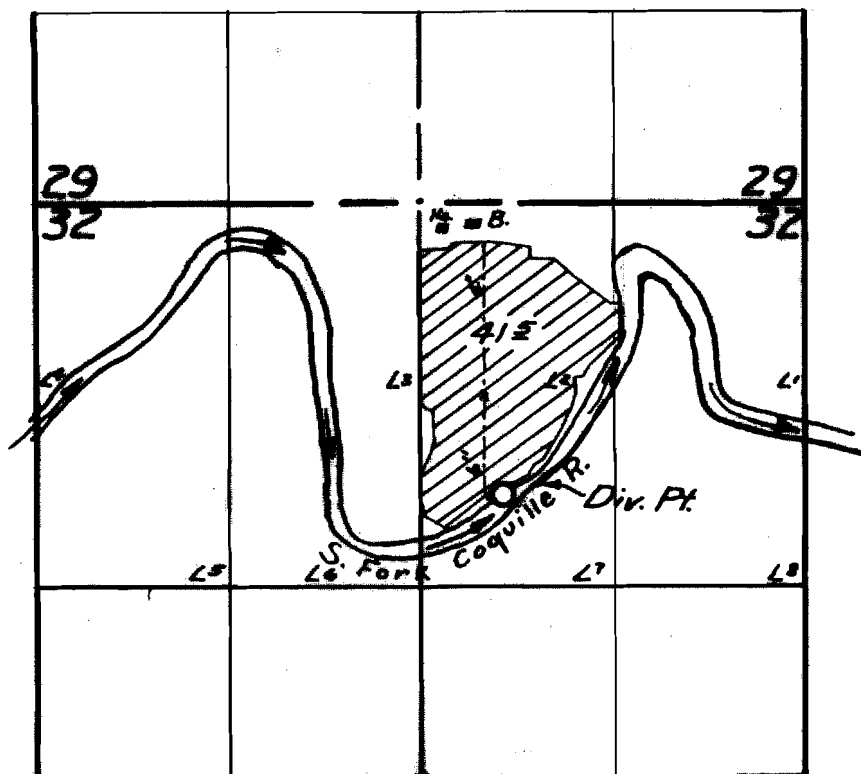

**FINAL PROOF SURVEY**

UNDER

Application No. 24131 Permit No. 18995

IN NAME OF

Raymond S & Laverne Garrano

Surveyed Aug. 11 1955, by M. Bish