


T.18S.R.46E.W.M.

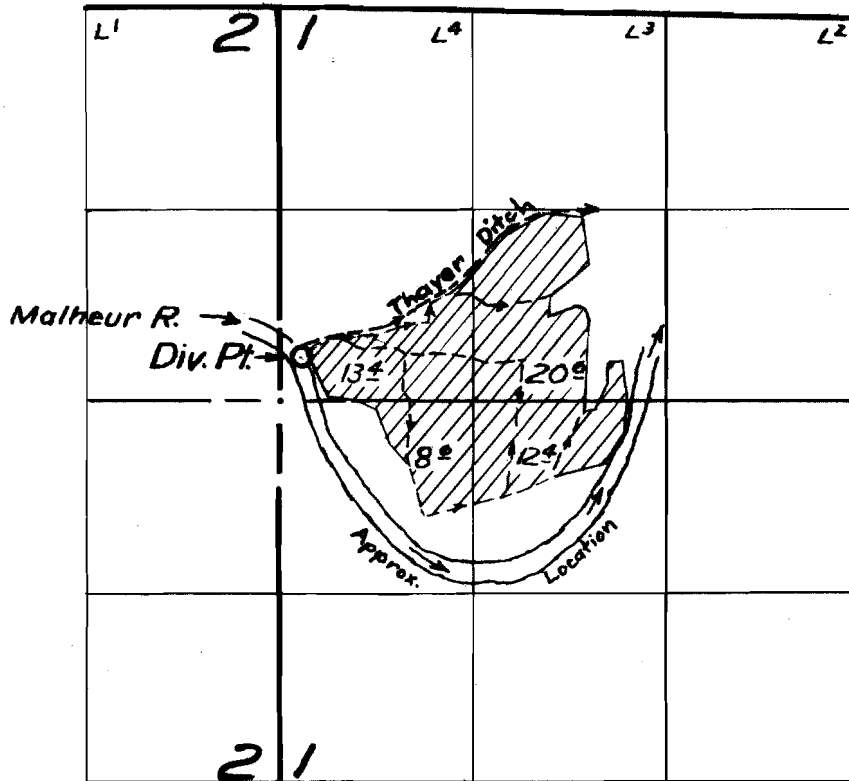

**FINAL PROOF SURVEY**  
UNDER

Application No. 24183 Permit No. 19203  
IN NAME OF

GEORGE A. LEWIS

Surveyed Oct. 6 1955 by M. Bish

1955N