


T.4S.R.3W.W.M.

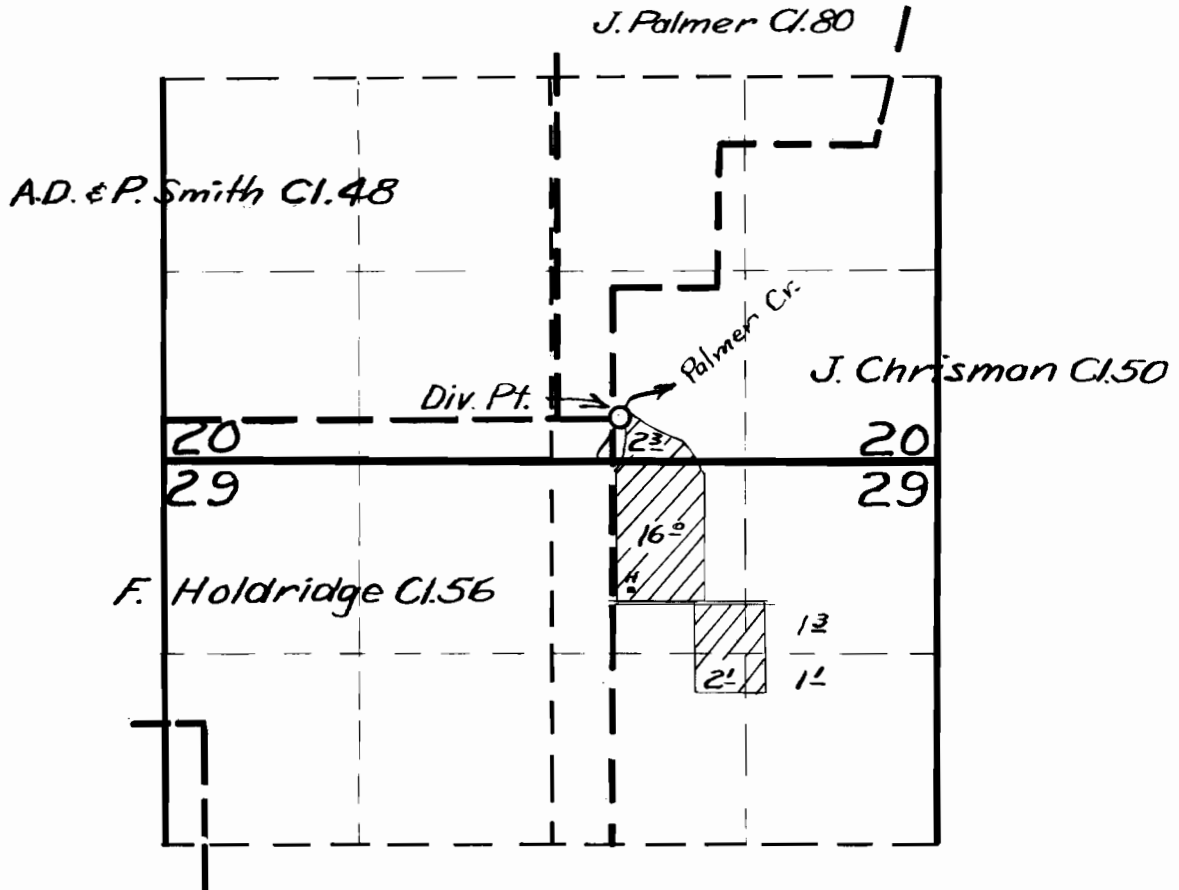

FINAL PROOF SURVEY
UNDER

Application No. 24522 Permit No. 19309
IN NAME OF

William King

Surveyed May 31 1955, by T. Jones