


T.35., R.2W.W.M

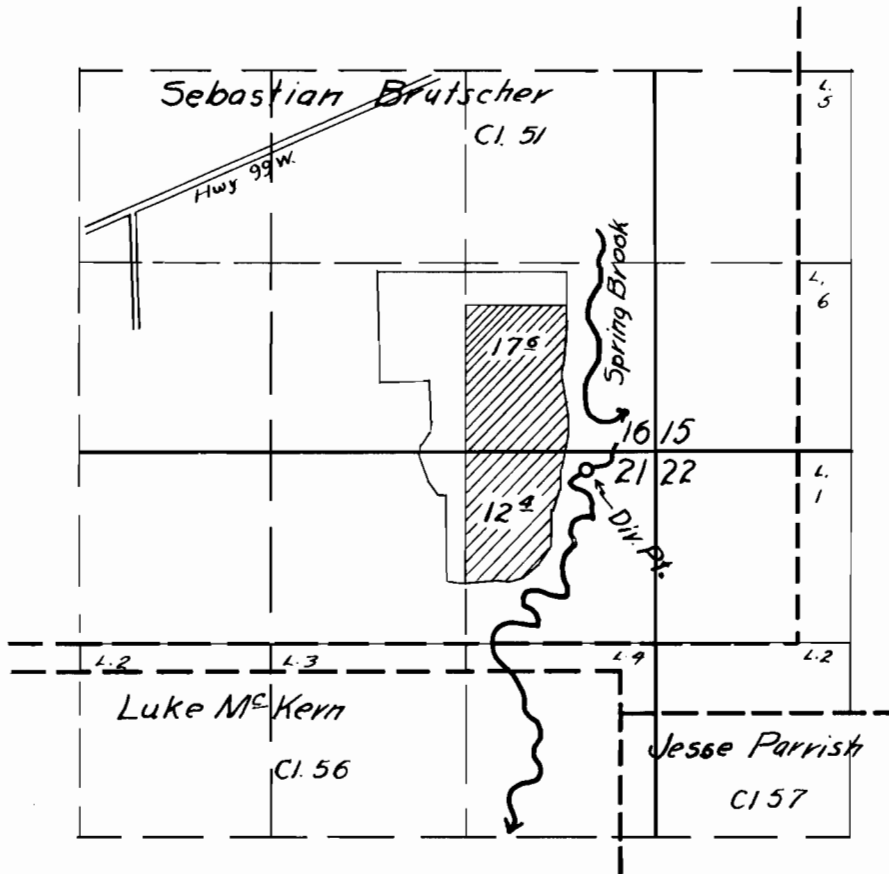

FINAL PROOF SURVEY
UNDER

Application No. 24549, Permit No. 19318
IN NAME OF

WILLIS K. CLARK

Surveyed 22 Sept. 1955, by *Robert H. Clark*