


T.6S. R.10W.W.M.

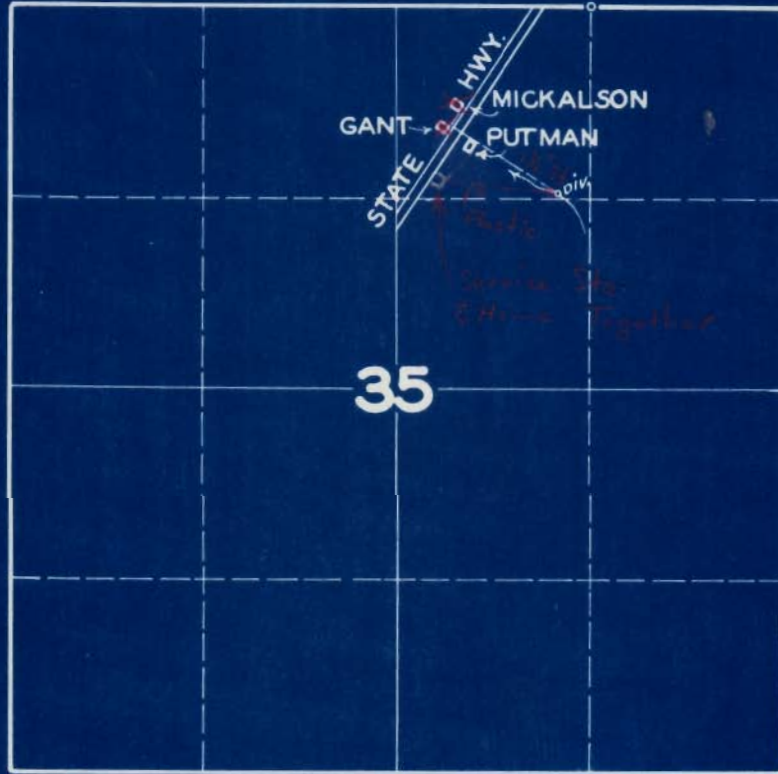

**FINAL PROOF SURVEY**

UNDER

Application No. 19895 Permit No. 15474

IN NAME OF

**HENRY GANT - KEN MICKALSON - R. ROY PUTMAN & MARIE M. PUTMAN**

Surveyed **AUG. 11, 1948**, by **JAS. E. BUNNELL**