


TISR9WWM

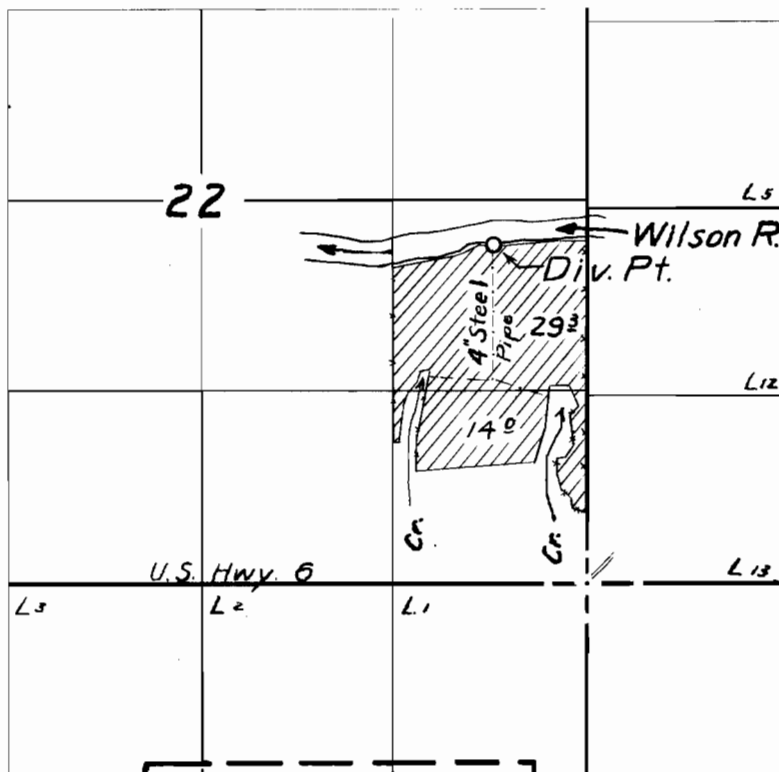

J. Champion C1.39

**FINAL PROOF SURVEY**

UNDER

Application No. 24572. Permit No. 19324.

IN NAME OF

**CHRIS WYSS**

Surveyed July 11, 1955, by *M. Bish*