


T.5S. R.4W.W.M.

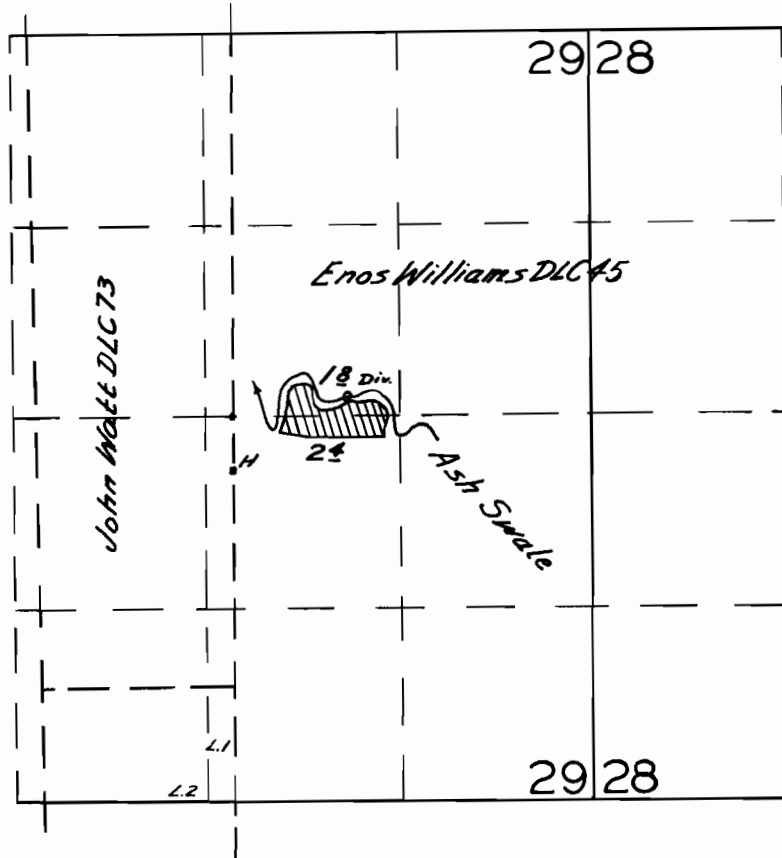

FINAL PROOF SURVEY
UNDER

Application No. 24471 Permit No. 19348
IN NAME OF

E. J. COCHRAN

Surveyed May 21 1955, by T. Jones