


T.2S.R.9W.W.M.

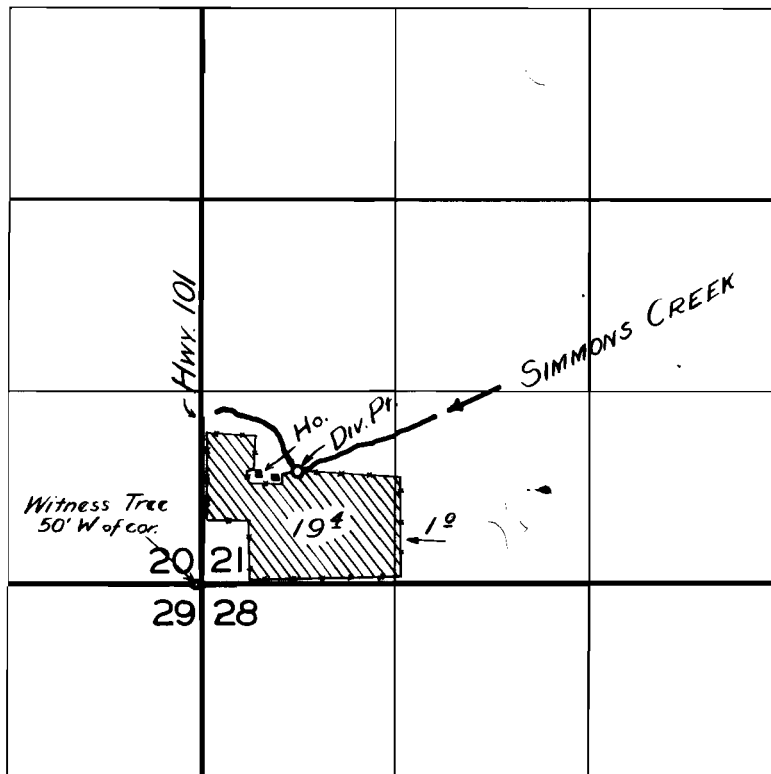

FINAL PROOF SURVEY

UNDER

Application No. 24761 Permit No. 19519

IN NAME OF

Frank Portman

Surveyed 8 Aug 1955, by

[Signature]