


East River Mac.

5200
3134

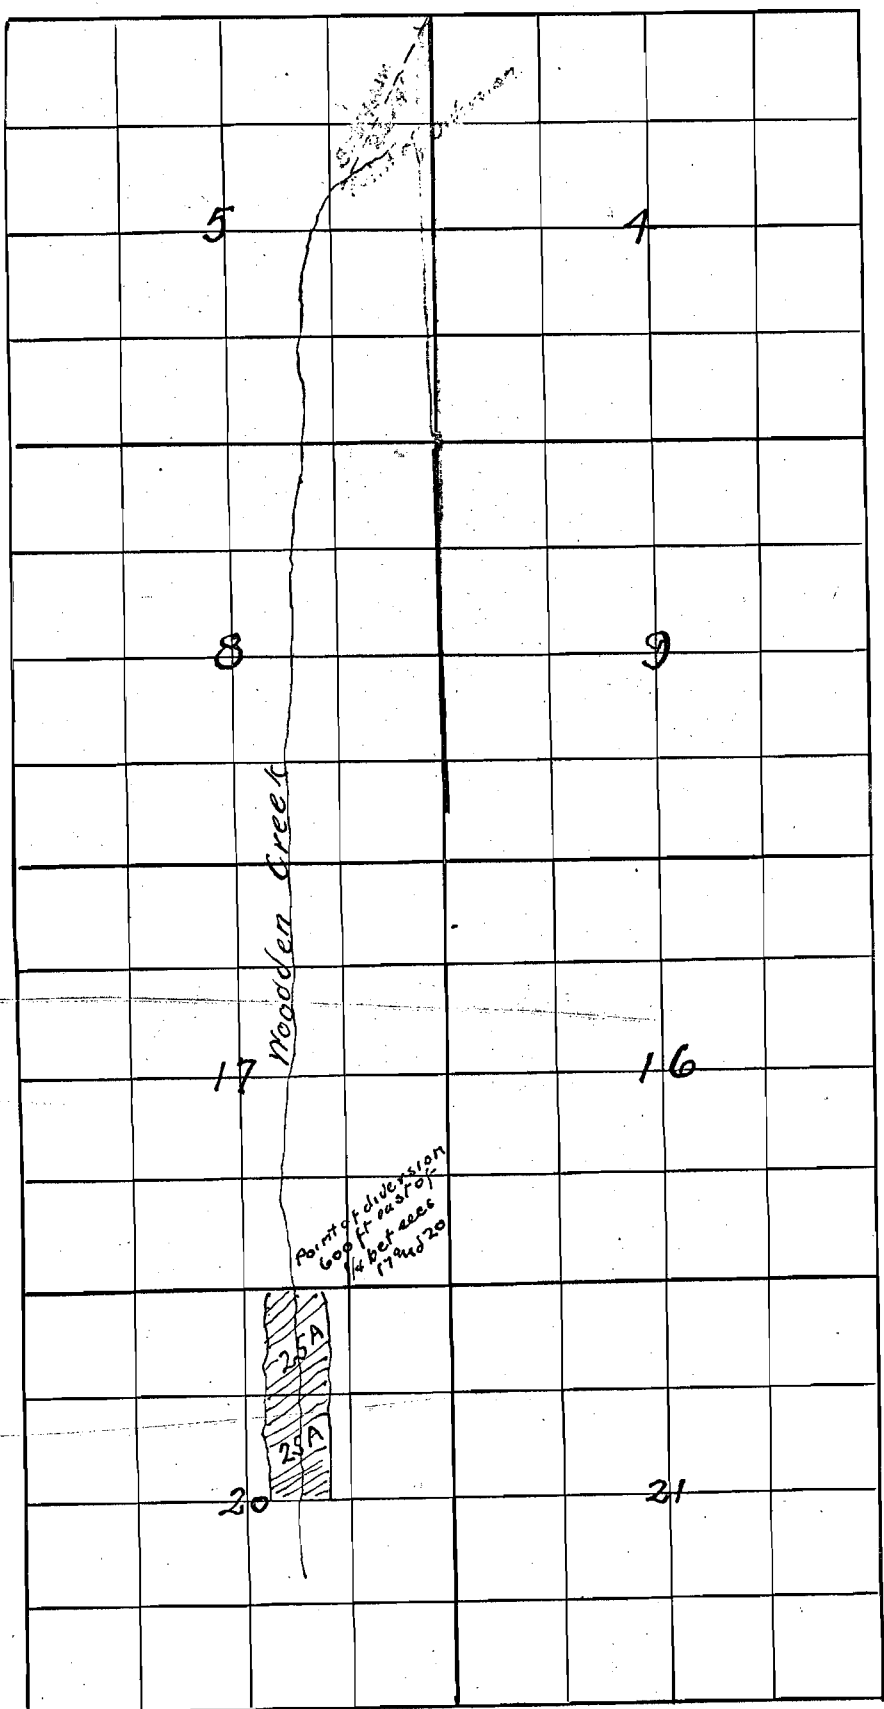

T415.R13E.