


T.135.R.10W.W.M.

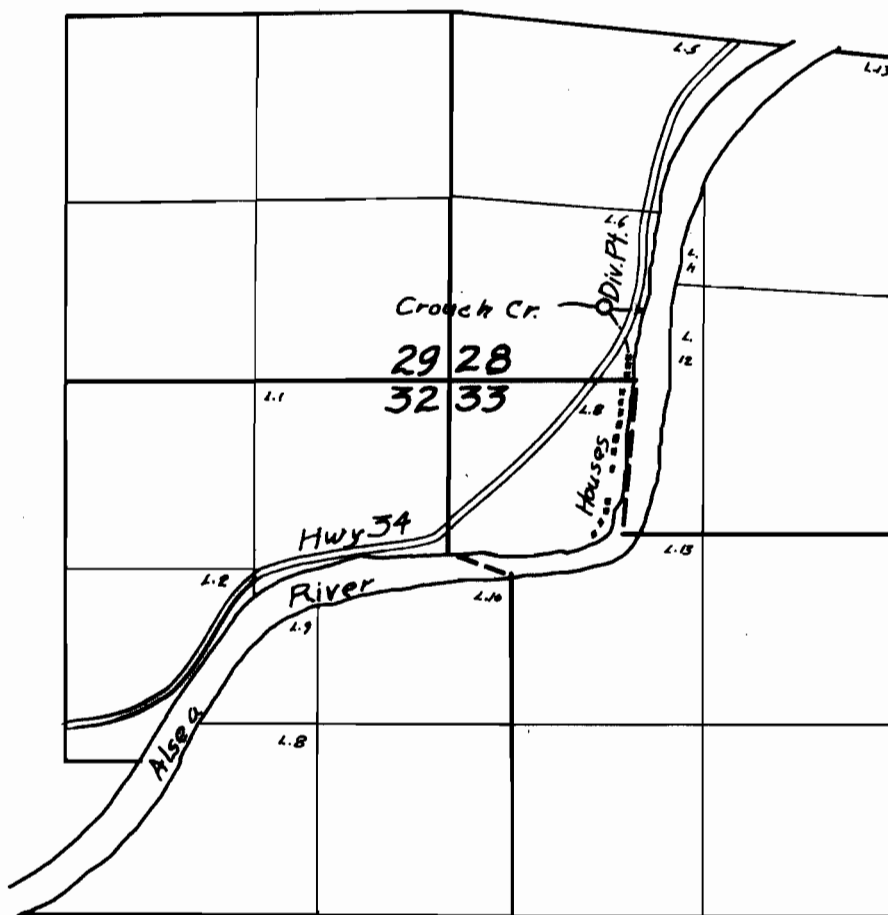

**FINAL PROOF SURVEY**  
UNDER

Application No. 25206... Permit No. 19812....  
IN NAME OF

**CROUCH...CREEK...WATER...ASSOCIATION**

Surveyed 20 April, 1955., by H.L. Coffman.....