


T.18S. R. 47E. W.M.

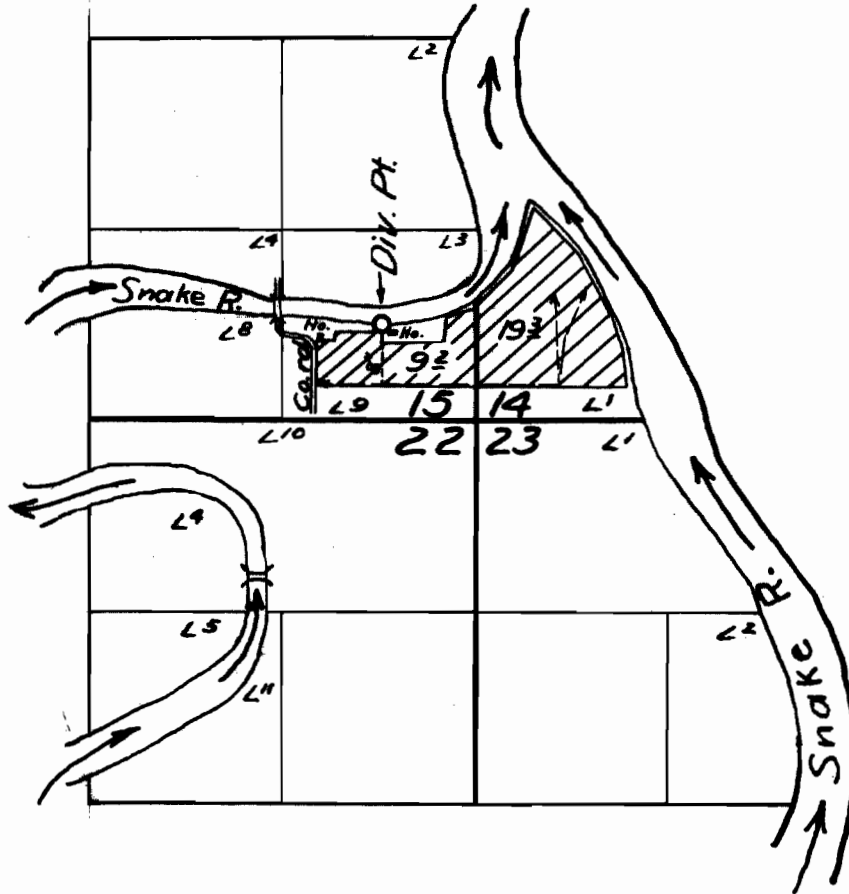

**FINAL PROOF SURVEY**

UNDER

Application No. 24638 Permit No. 19925

IN NAME OF

**B.E. CARSON**

Surveyed Oct. 4 1955, by M. Bish