


T142SR9WWM

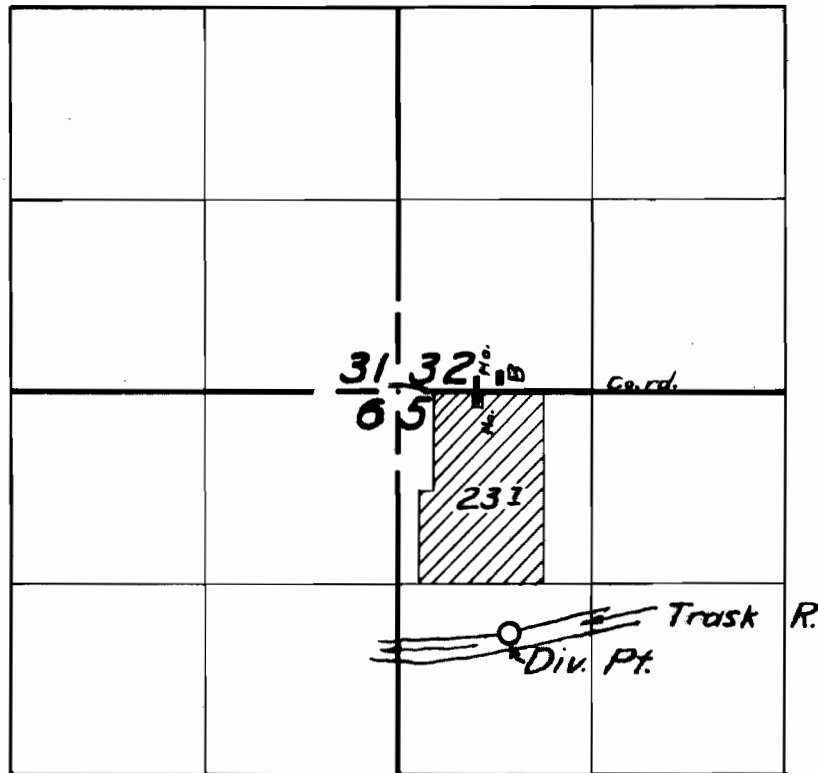

FINAL PROOF SURVEY

UNDER

Application No. 25385 Permit No. 19994

IN NAME OF

BERTHA HUNT

Surveyed July 25 1955, by M. Bish