


T. 2 S. R. 44 E. W. M.

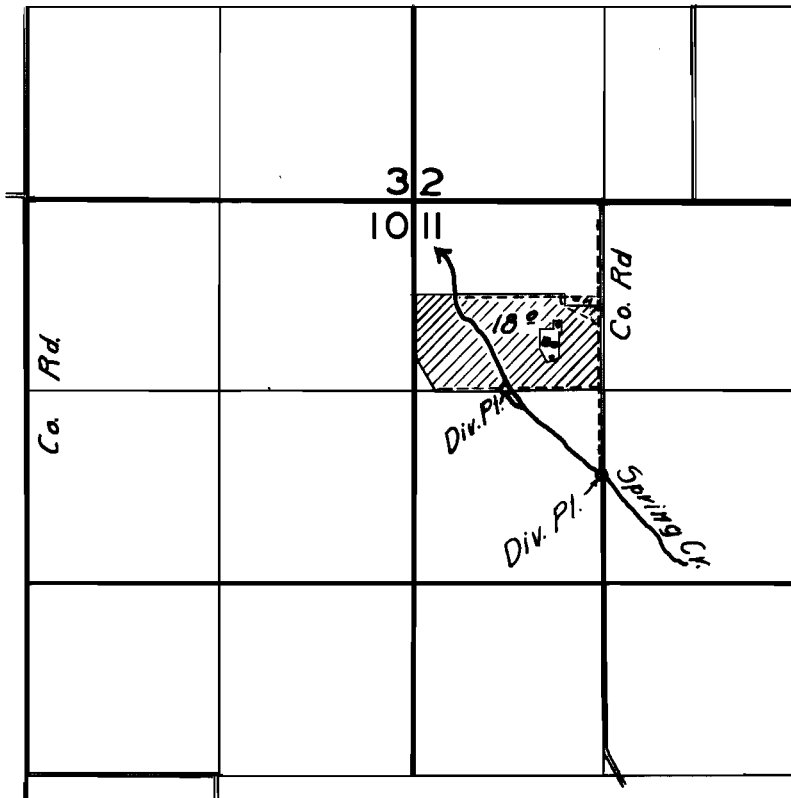

FINAL PROOF SURVEY

UNDER

Application No. 26269 Permit No. 20619

IN NAME OF

W. M. & J. DE MOISE WHITE

Surveyed 9 Aug 1955, by *Robert H. Reed*