


T.3S.R.10W.W.M.

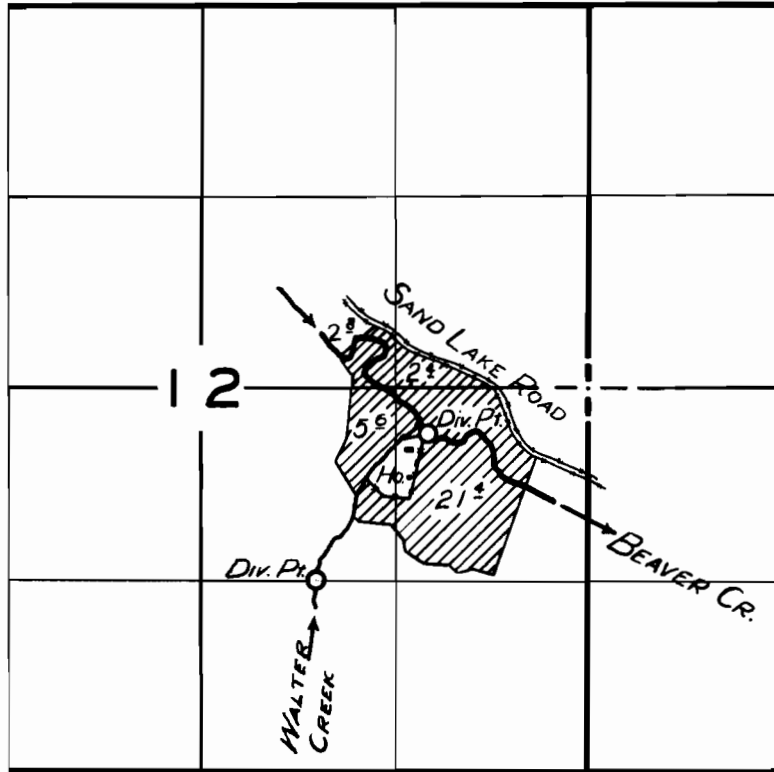

FINAL PROOF SURVEY

UNDER

Application No. 26422 Permit No. 20722

IN NAME OF

ULRICH WYSS, JR.

Surveyed 24 Aug 1955, by *H. A. Whitby*

1955-E