


T. 5 S. R. 4 W. W.M.

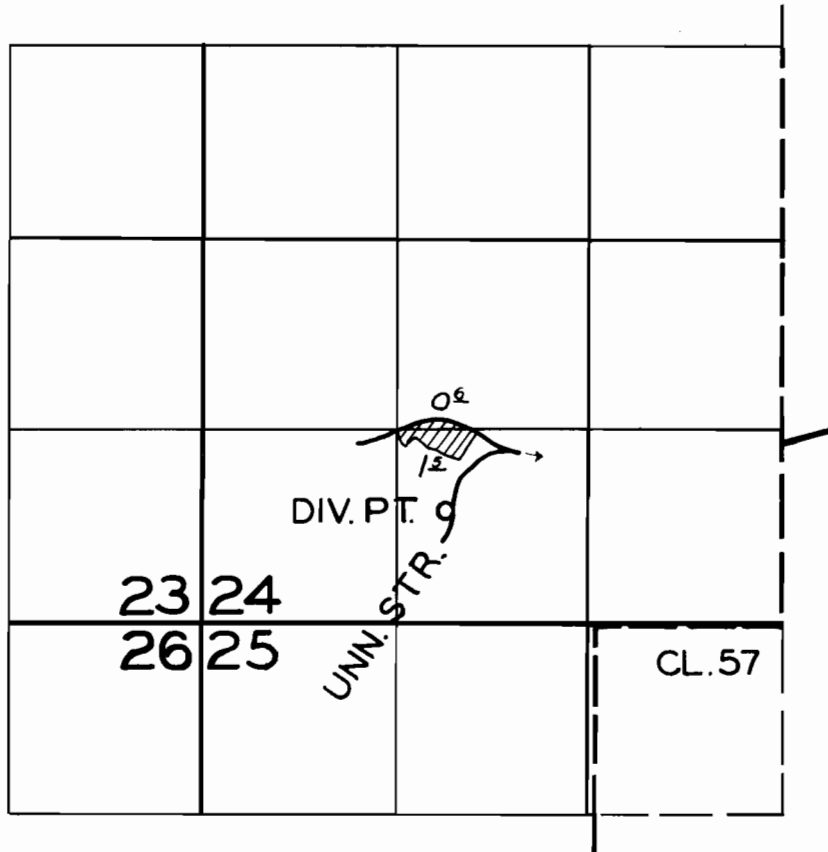

FINAL PROOF SURVEY  
UNDER

Application No. 26600 Permit No. 20835  
IN NAME OF

RAY H. SNYDER

Surveyed 20 MAY 1955 by T. JONES