


T.29 S. R. 11 W. W.M.

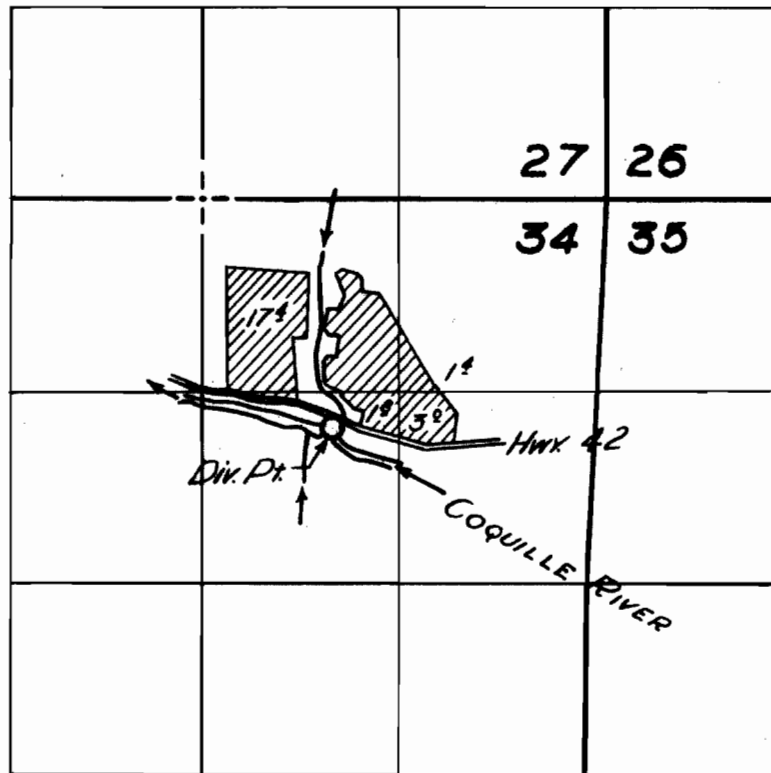

**FINAL PROOF SURVEY**  
UNDER

Application No. 26726 Permit No. 20916  
IN NAME OF

POWELL LANCASTER

Surveyed 18 Mar 1955, by T. JONES

1955-Y