


T. 41 S., R. 4 W., W.M.

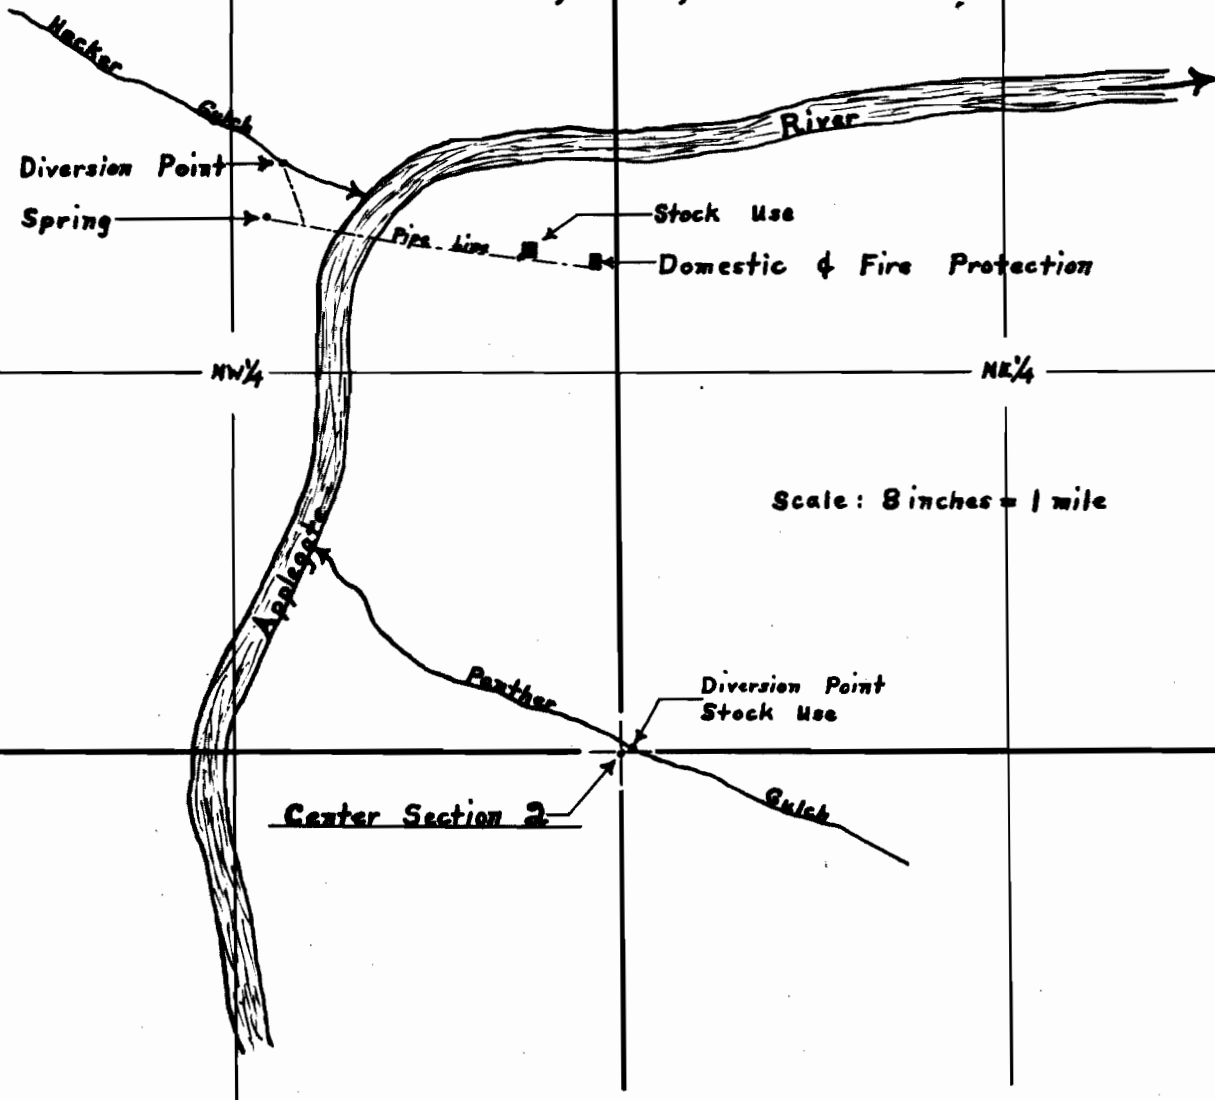

# FINAL PROOF SURVEY

UNDER

Application No. 28141 Permit No. 22148  
IN NAME OF

Bert and Christine Harr

Surveyed March 13, 1956, by D.C. Hendrix, W.M.