


T. 13 S. R. 15 E. W. M.

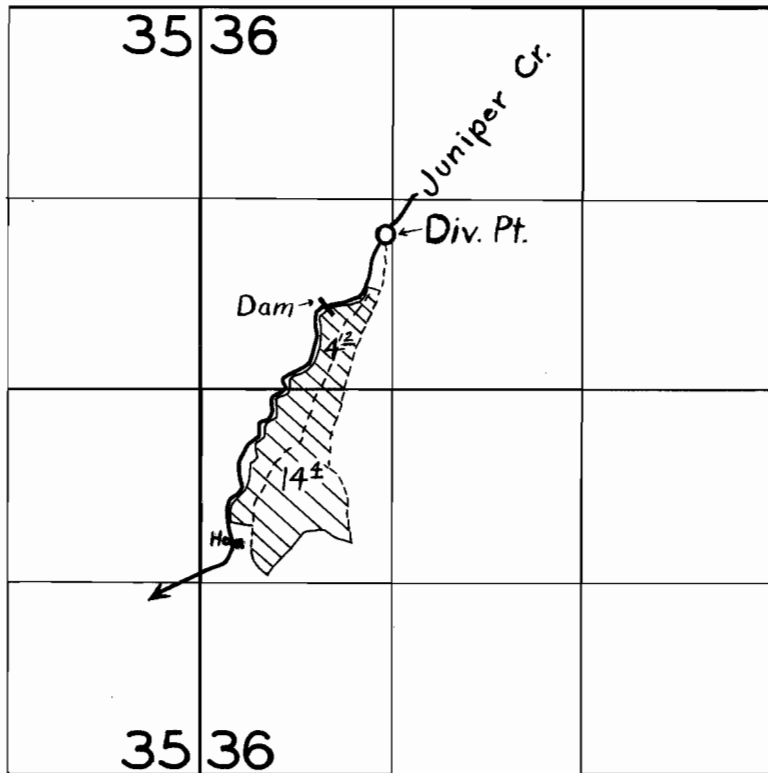

FINAL PROOF SURVEY

UNDER

Application No. 28242 Permit No. 22211

IN NAME OF

GILBERT E. SHARP

Surveyed 27 APR. 1955, by T. JONES