


T.2S.R.9.W.WM

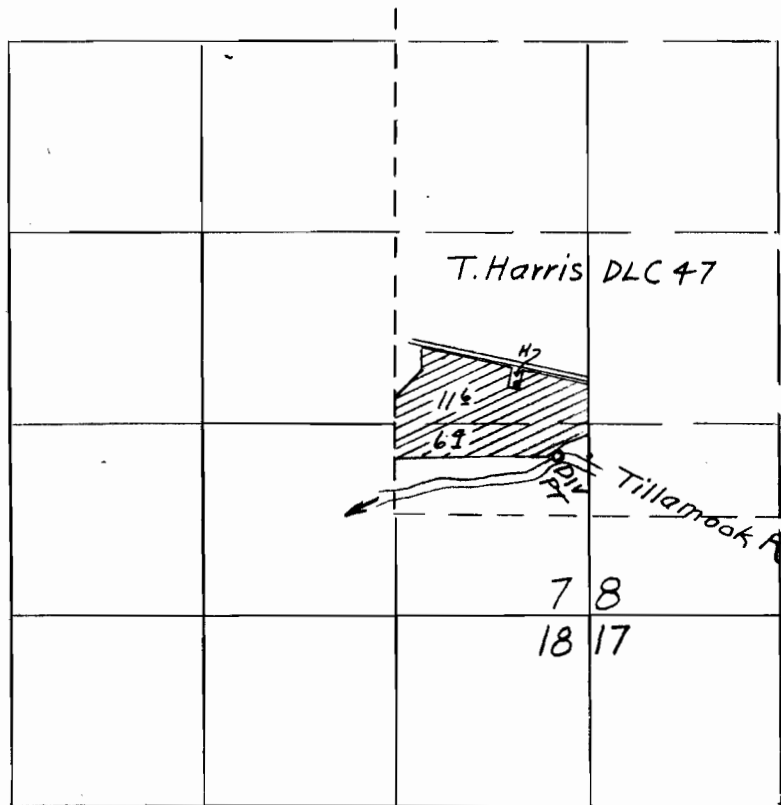

FINAL PROOF SURVEY
Under

Application 28304 Permit 22254
In name of

William M. Plasker

Surveyed Aug 8 1955 by R.H. Whitby