


T. 26 & 27 S. R. 11 W. W.M.

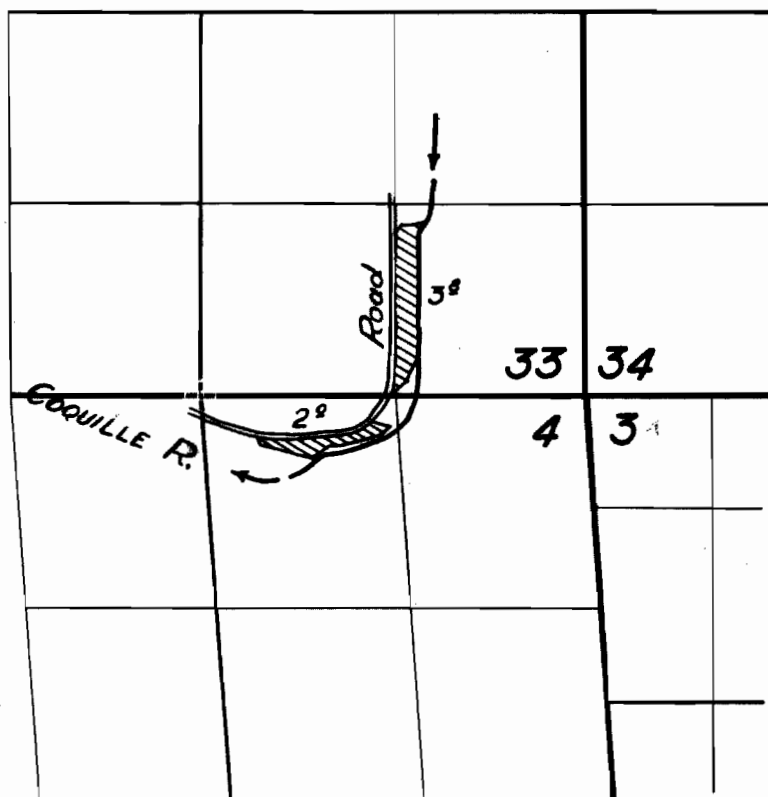

FINAL PROOF SURVEY

UNDER

Application No. 28879 Permit No. 22709

IN NAME OF

MORRIS VIGUE

Surveyed 3 March 1955, by T. JONES

1955-Z1