


T.2 S., R.44 & 45 E. W.M.

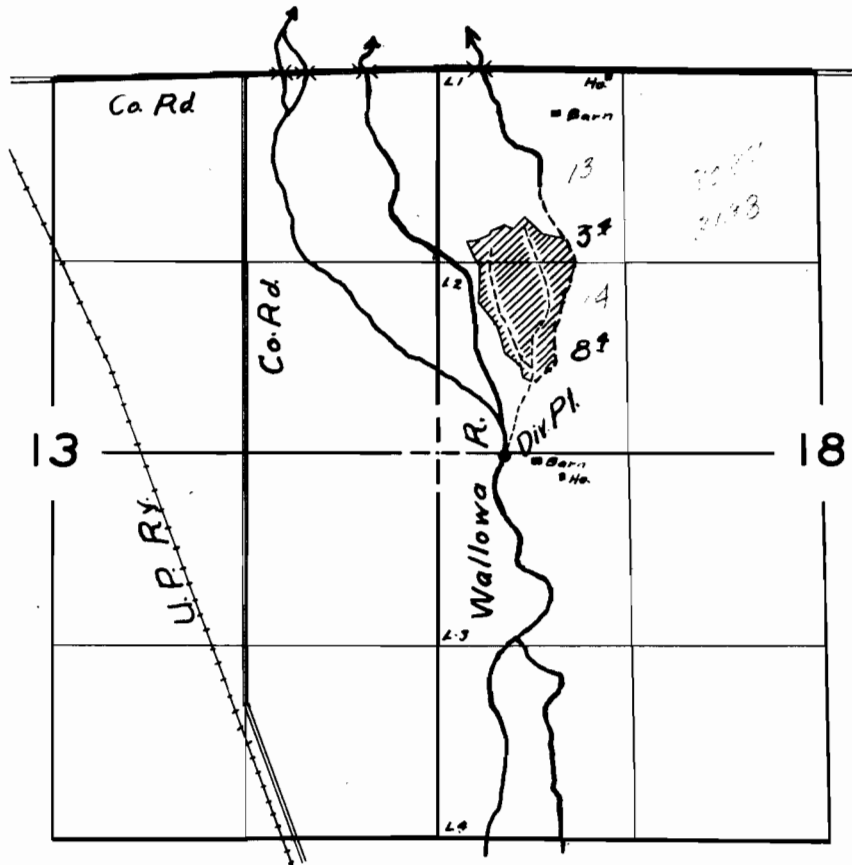

FINAL PROOF SURVEY

UNDER

Application No. 28881... Permit No. 22822

IN NAME OF

GLARA MARIE BURDETT

Surveyed 10 August 1955, by [Signature]