


T. 5 S. R. 3 & 4 W. W. M.

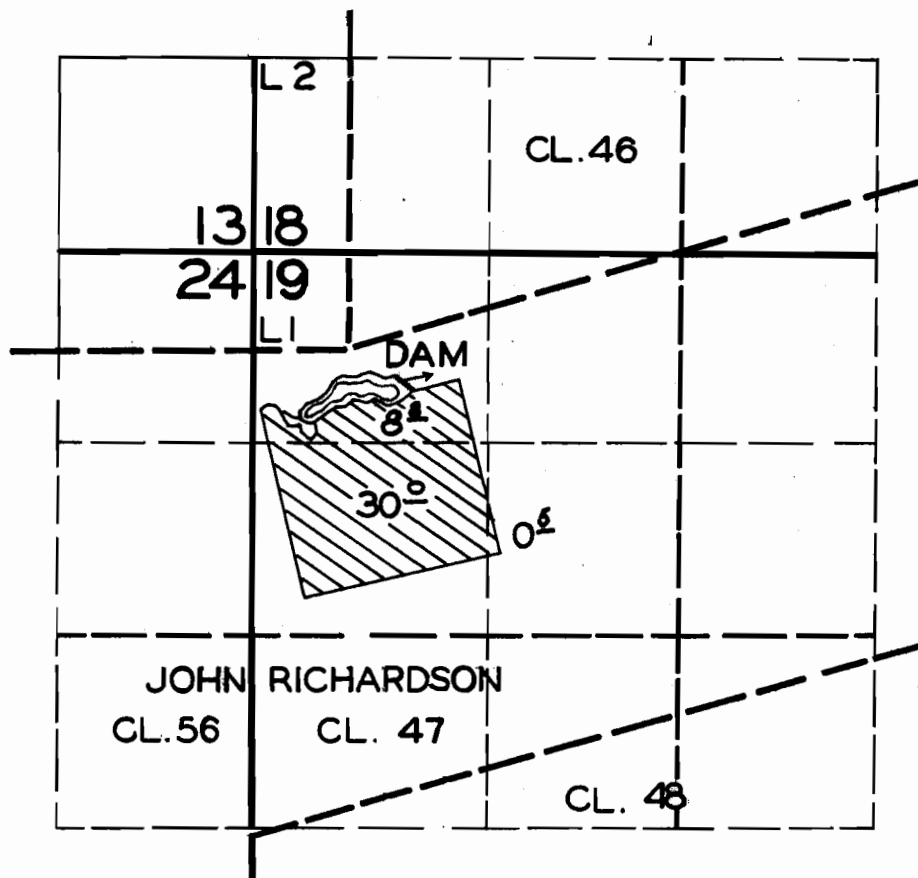

FINAL PROOF SURVEY

UNDER

R-21038

R-823

Application No. 21037... Permit No. 16484.

IN NAME OF

CARL WOOD

Surveyed 20MAY 1955, by T. JONES.